


T. 1 N., R. 2 & 3 W., W. M.

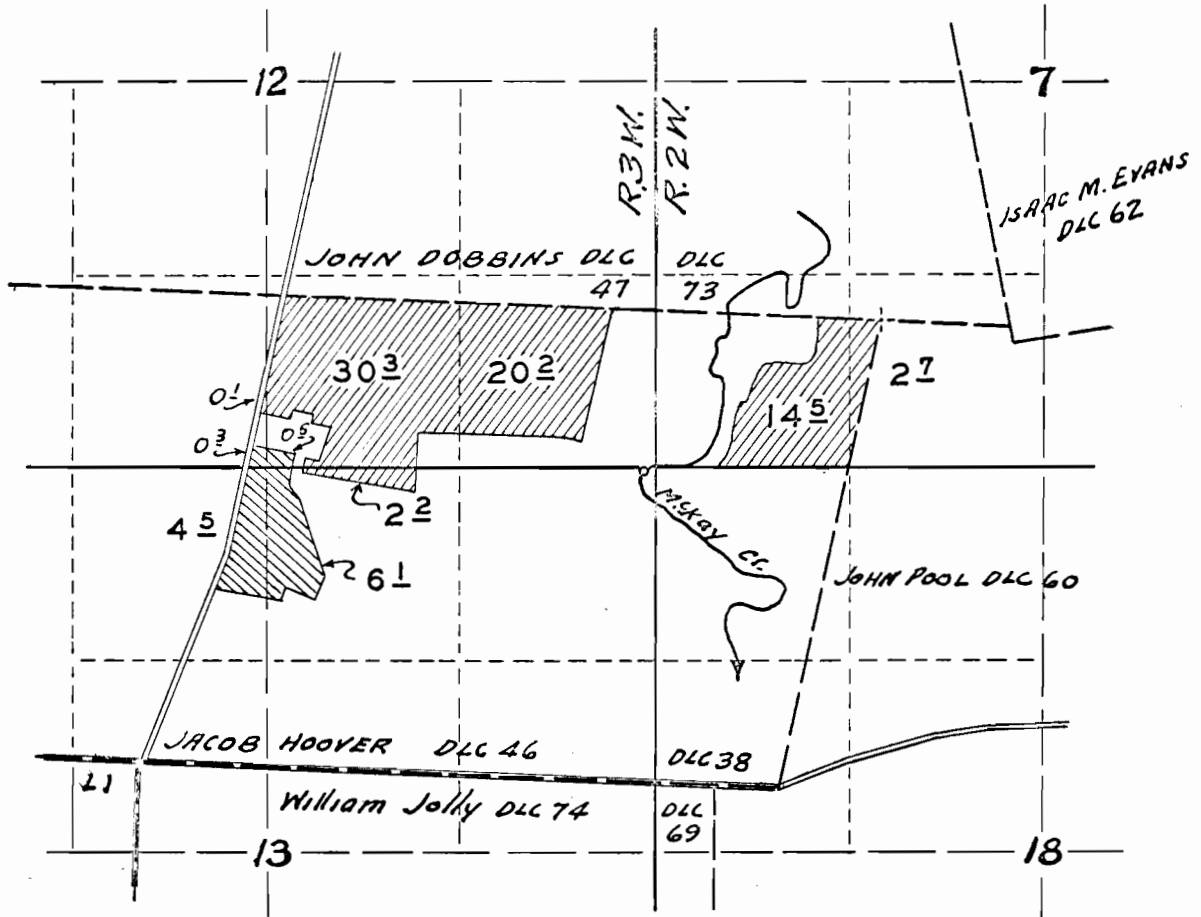

FINAL PROOF SURVEY

UNDER

22114

17378

Application No. 23703 Permit No. 18719

IN NAME OF

REMI COUSSENS

Surveyed 4 - 11 1956 by M. BISH