


T. 1 N. R. 2 & 3 W. W. M.

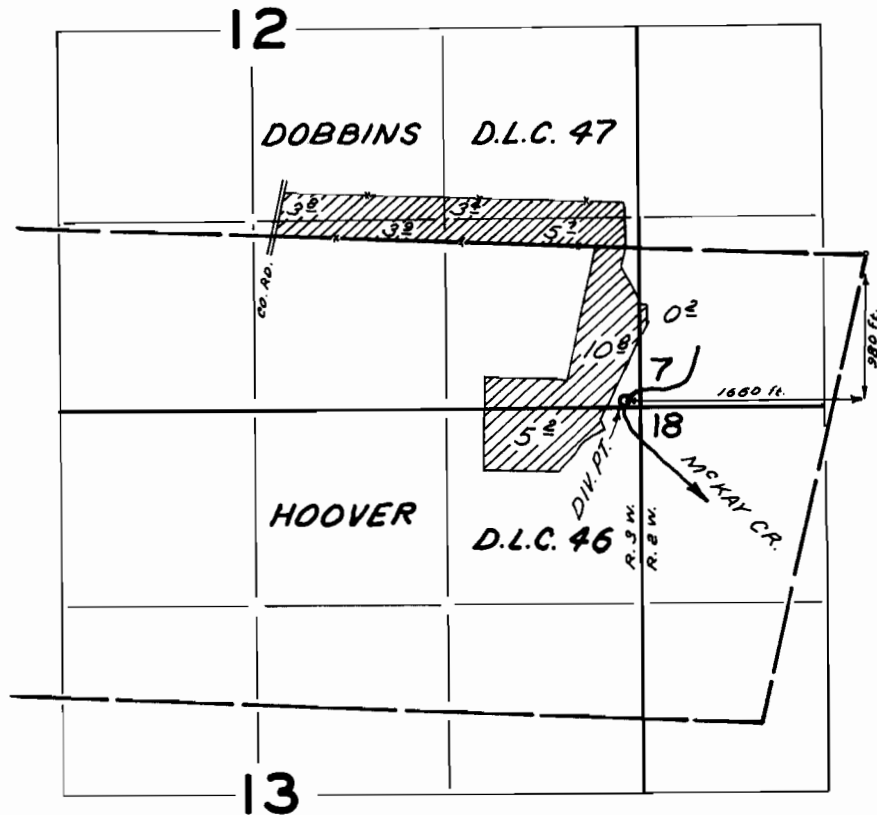


FINAL PROOF SURVEY UNDER

Application No. 38680 Permit No. 28780
IN NAME OF

REMI COUSSENS

Surveyed APR. 4 1967, by W. J. RUPPERT

T. 1 N. R. 2 & 3 W. W. M

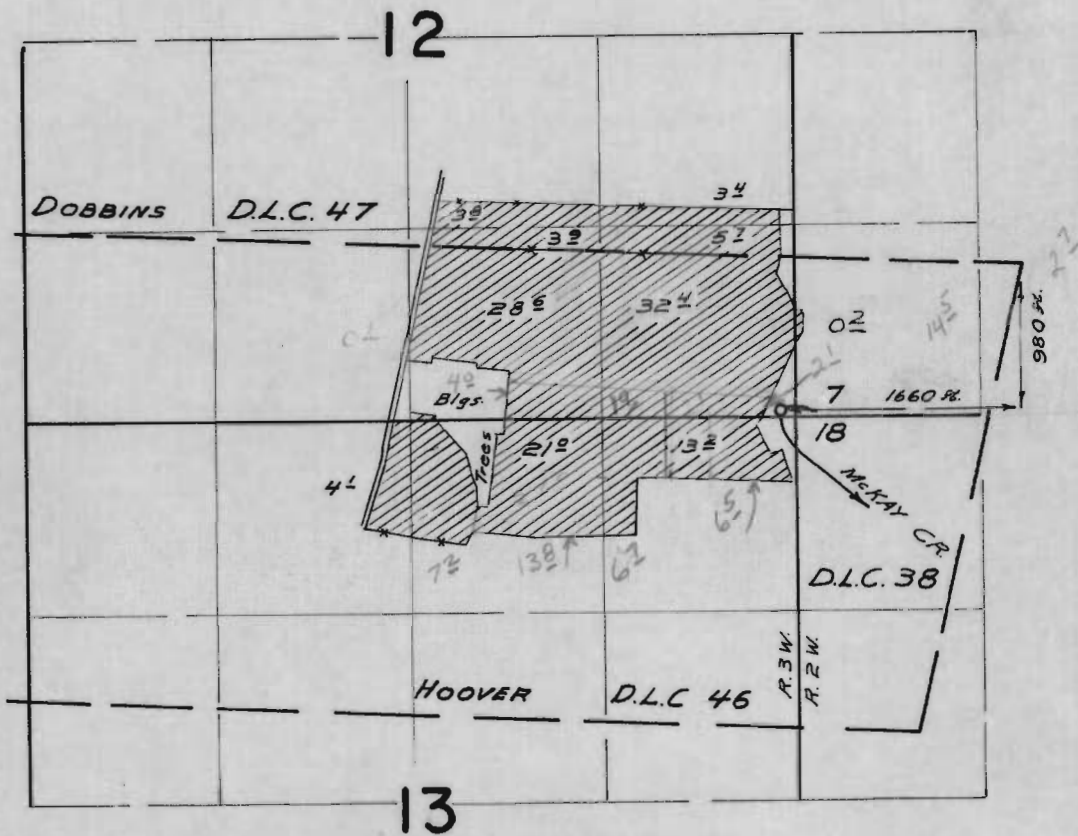

FINAL PROOF SURVEY UNDER

Application No. 38680 Permit No. 28780
IN NAME OF

REMI COUSSENS

Surveyed April 4, 1967, by W. d. Ruppert.