


See "Other" Final Proof map for more accurate acreage location.

T.7S.R.19E.W.M.

19

20

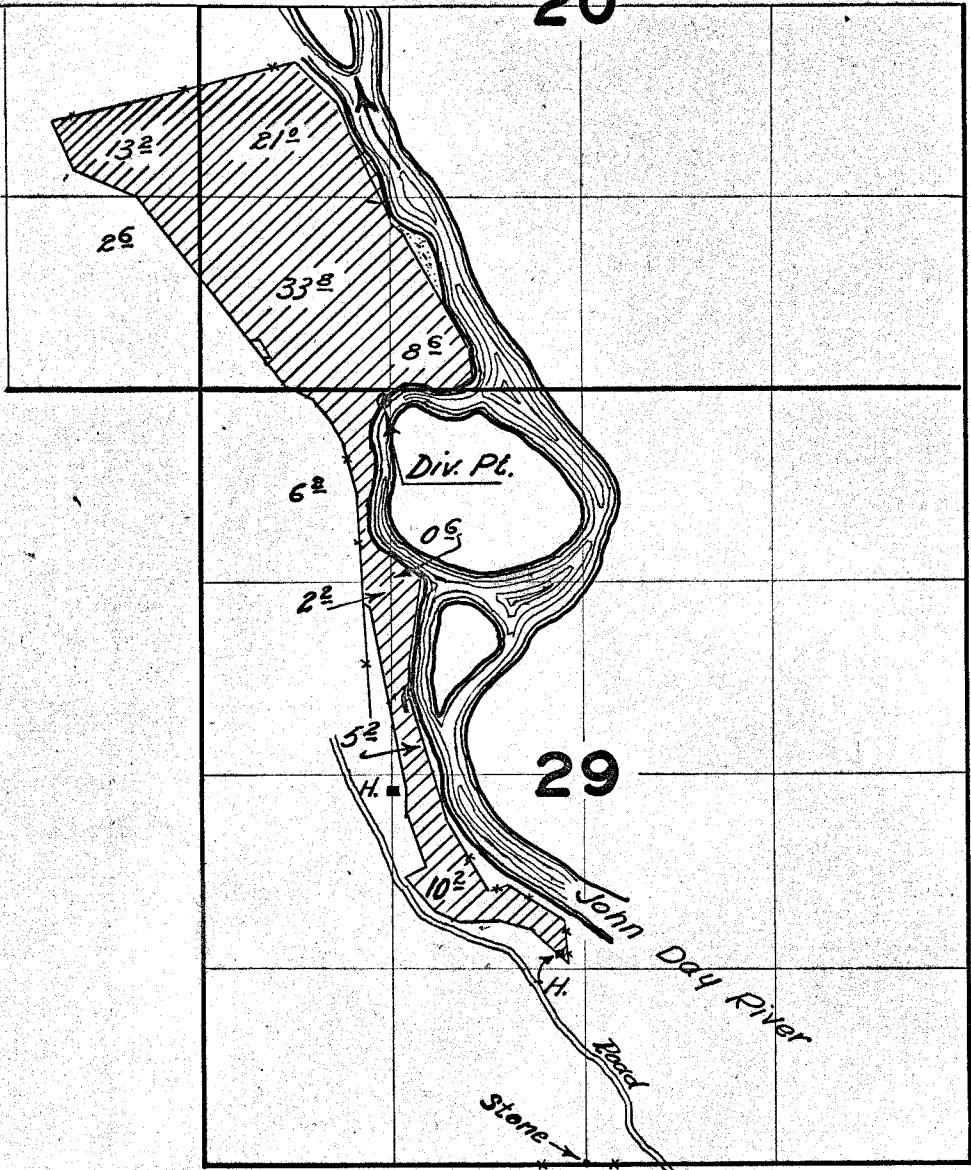

FINAL PROOF SURVEY UNDER

Application No. 22244 Permit No. 17507
IN NAME OF

Martin W. Nill

Surveyed June 17, 1954, by H. L. Coffman