


T.2&3S. R.3E.W.M.

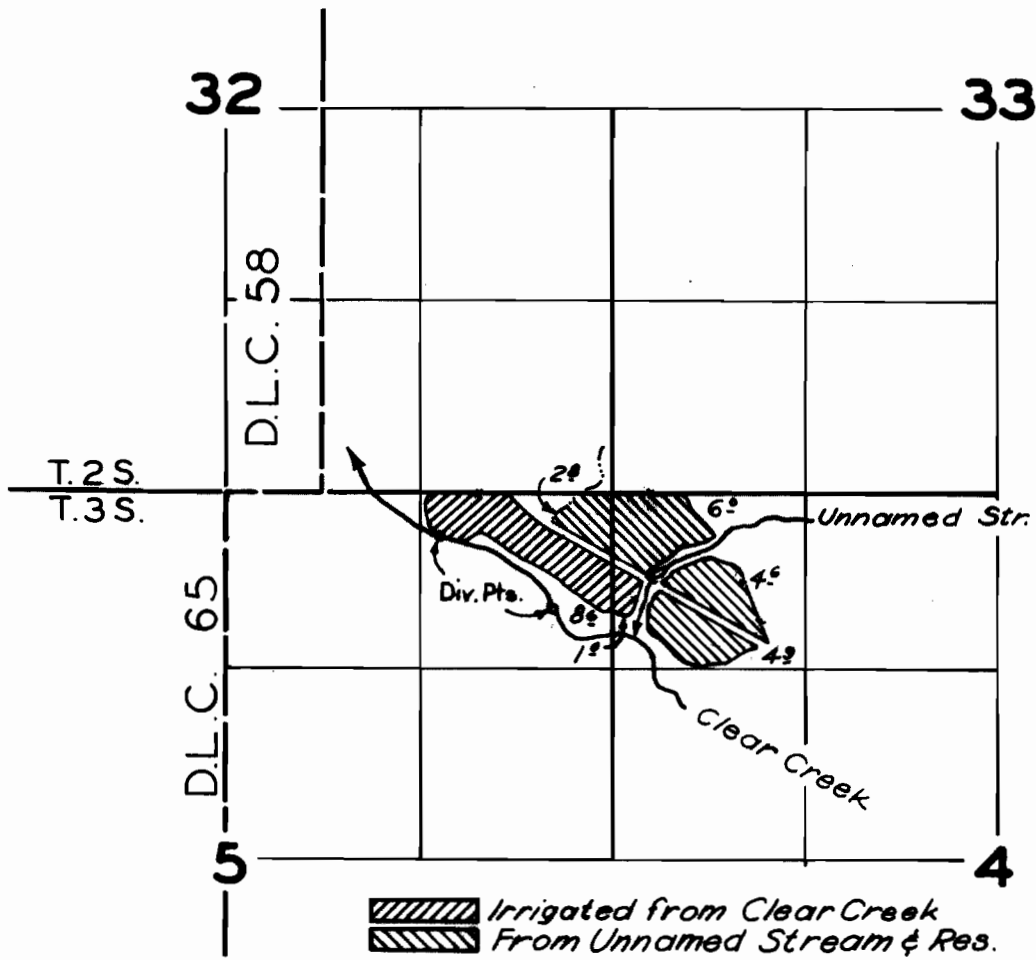

**FINAL PROOF SURVEY**  
UNDER

R-31045                      R-1967  
Application No. ~~31046~~      Permit No. 24595...  
IN NAME OF

**HARTLEY JOHNSON**

Surveyed 20 April 1960, by *[Signature]*