


T.3S.R.1W.W.M.

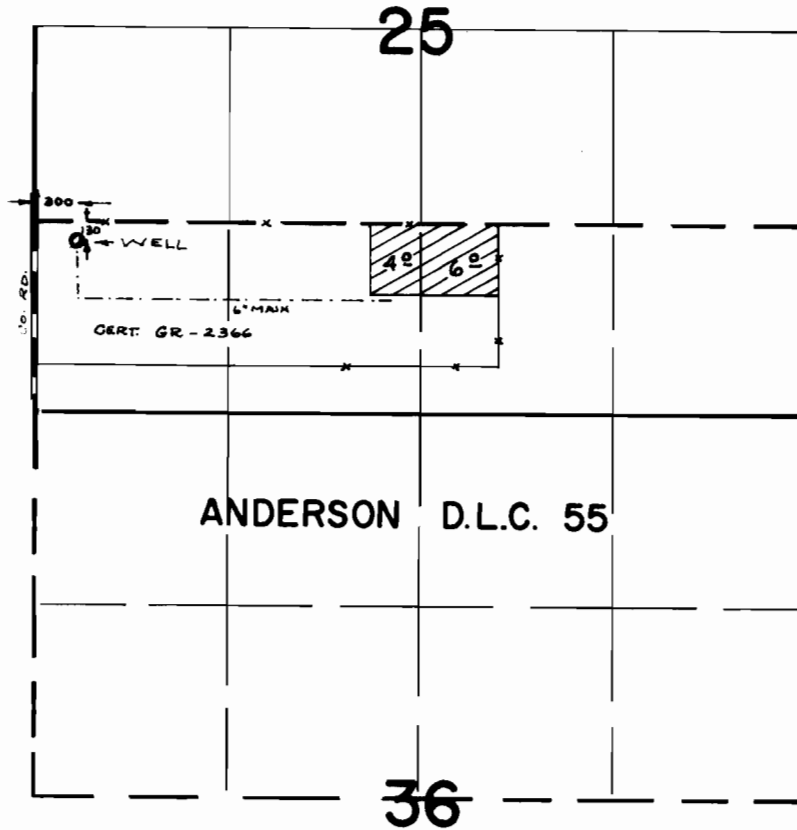

FINAL PROOF SURVEY
UNDER

Application No. ~~G-2602~~ Permit No. ~~G-2450~~
IN NAME OF

WAYNE RUSSELL

Surveyed MAY 12, 1971, by R. MUCKEN