


T.1S.R.3E.W.M.

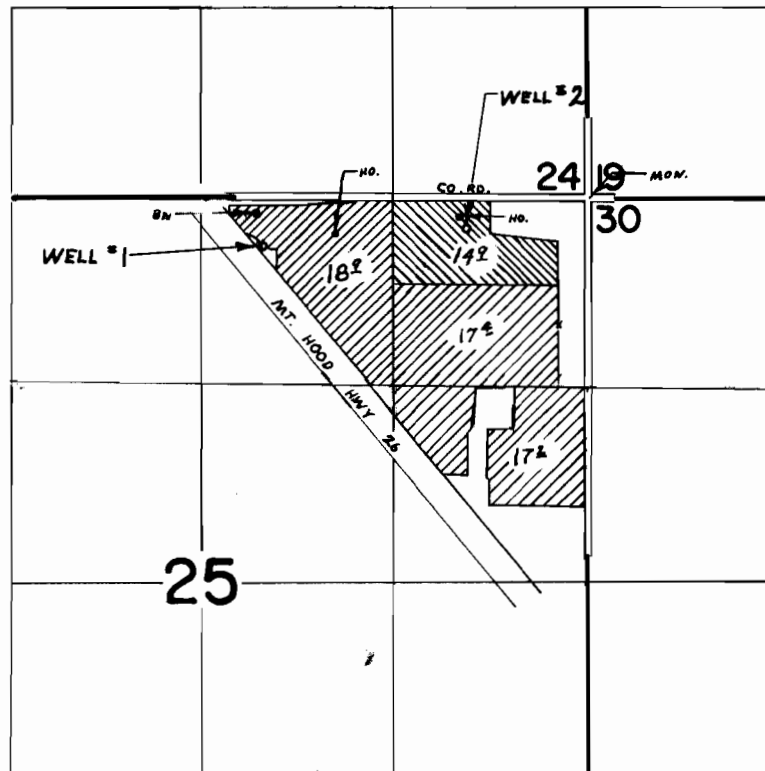

 G 3464  G 3465

WELL 1 LOC. 340'S 2240'W FROM NE COR. SEC. 25
WELL 2 LOC. 210'S 840' W FROM NE COR. SEC. 25

FINAL PROOF SURVEY UNDER

G 3464 G 3268
Application No. G 3465 Permit No. G 3269
IN NAME OF

KENNETH R. STONE

Surveyed JULY 30, 1971, by R. MUCKEN