


T. 3 S. R. 2 E. W. M.

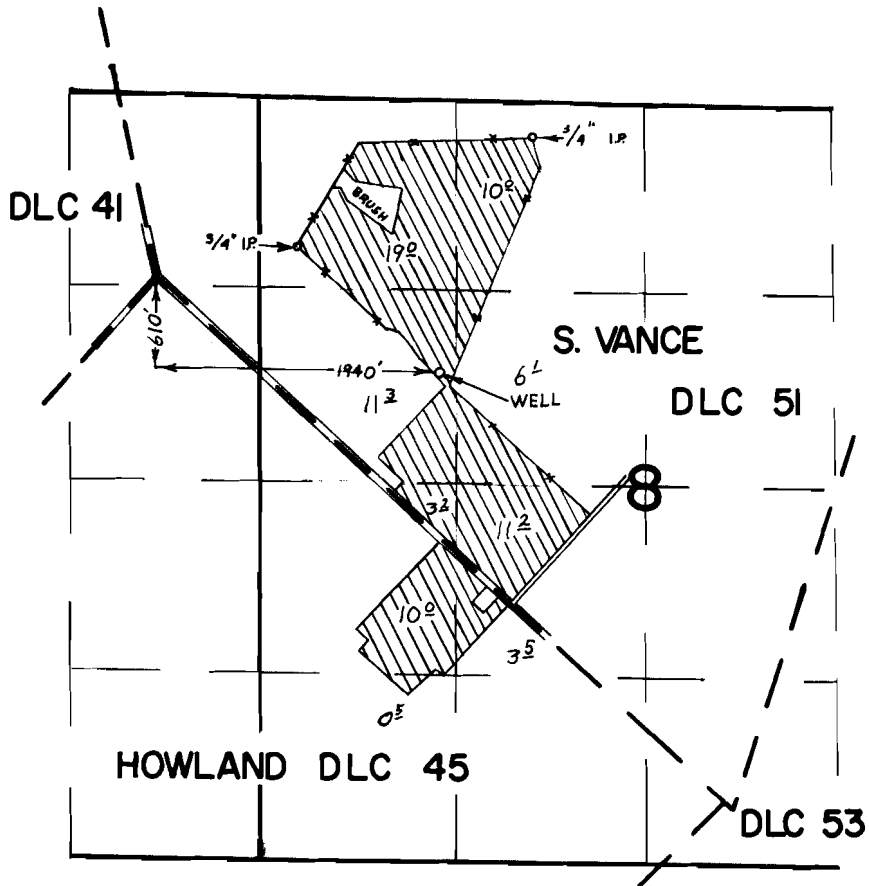

FINAL PROOF SURVEY UNDER

Application No. G-4294 Permit No. G-4042
IN NAME OF

RUDOLPH PAVLINAC, JR.

Surveyed AUG. 17, 1971, by R. MUCKEN