


T.3S.R1E.W.M.

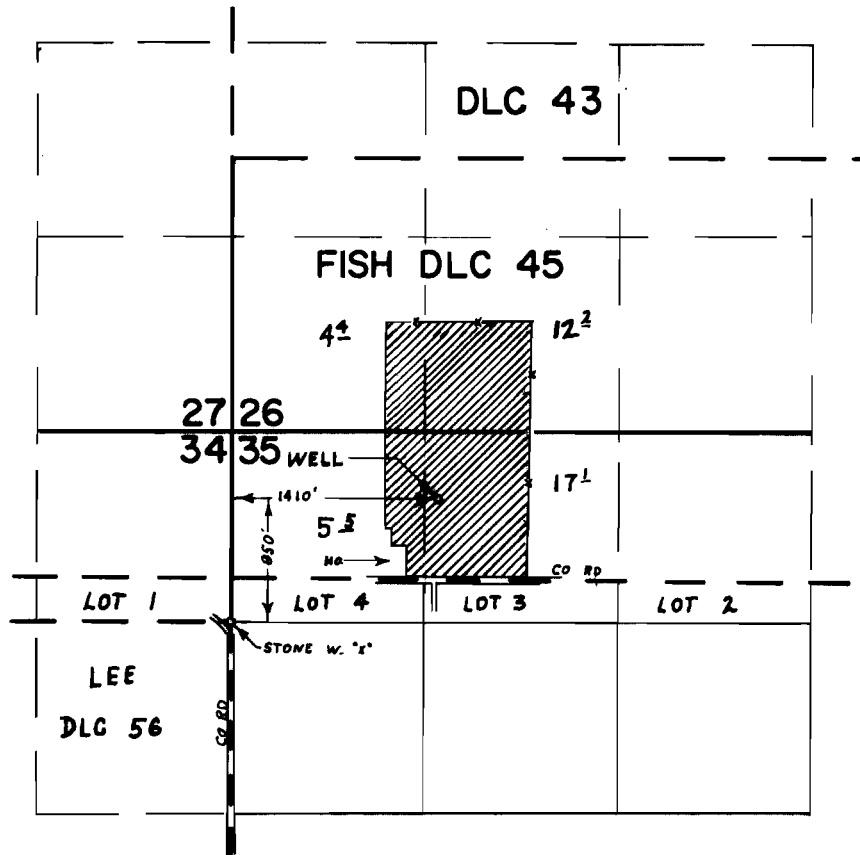

FINAL PROOF SURVEY
UNDER

Application No. G.4417... Permit No. G.4183...
IN NAME OF

.....ALOIS F. DELFORGE.....

Surveyed JULY 28, 1971., by R. MUCKEN.....