


T. 3 & 4 S. R. 2 E. W. M.

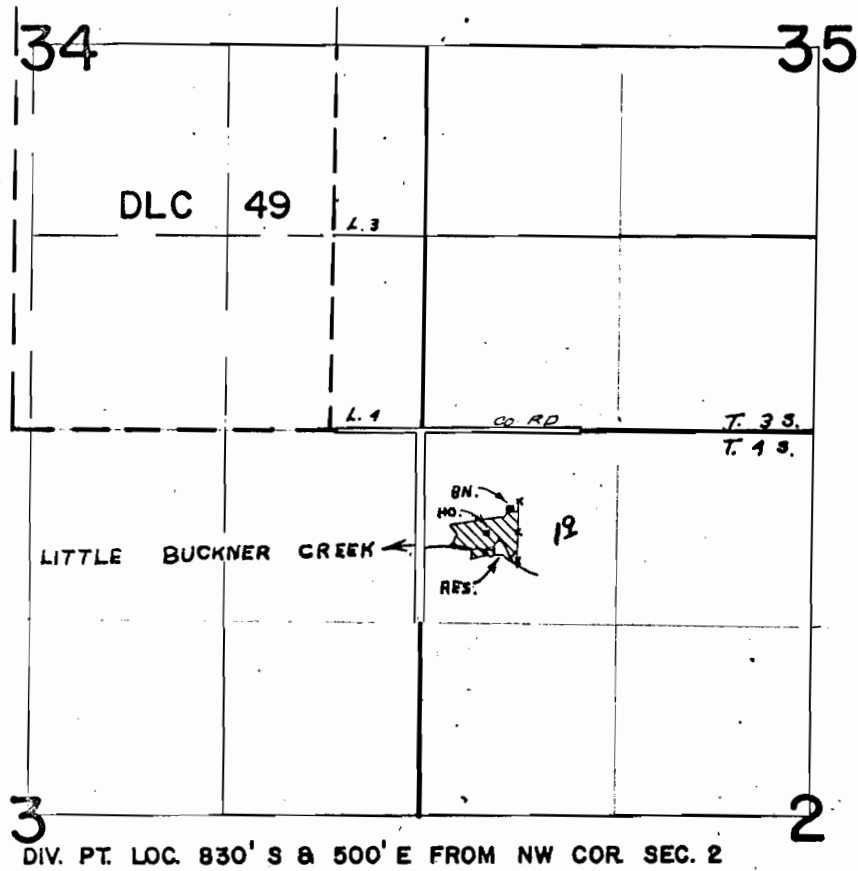

FINAL PROOF SURVEY

UNDER

Application No. R-40112 Permit No. R-4466
40113 29906
 IN NAME OF

.....E. L. & JEWEL JIMISON.....

Surveyed OCT...8... 1971, by ..R..MUCKEN.....