


T. 3 & 4 S. R. 2 E. W. M.

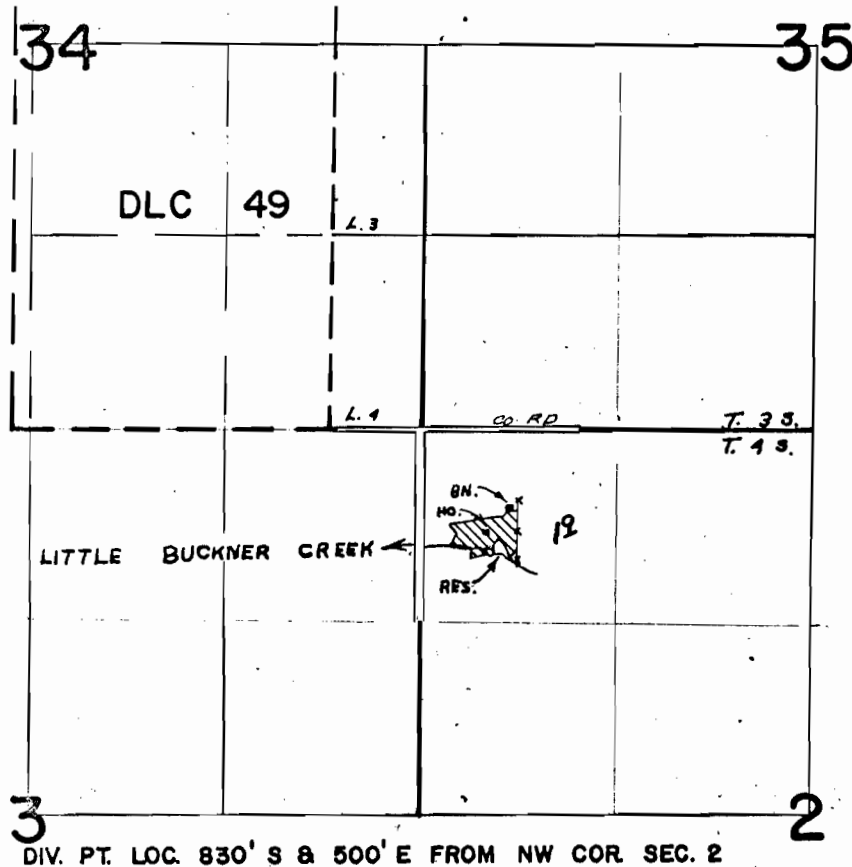

FINAL PROOF SURVEY

UNDER

Application No. R-40112 Permit No. R-4466
40113 29906
 IN NAME OF

E. L. & JEWEL JIMISON

Surveyed OCT. 8, 1971, by R. MUCKEN