


T.4S.R.3E.W.M.

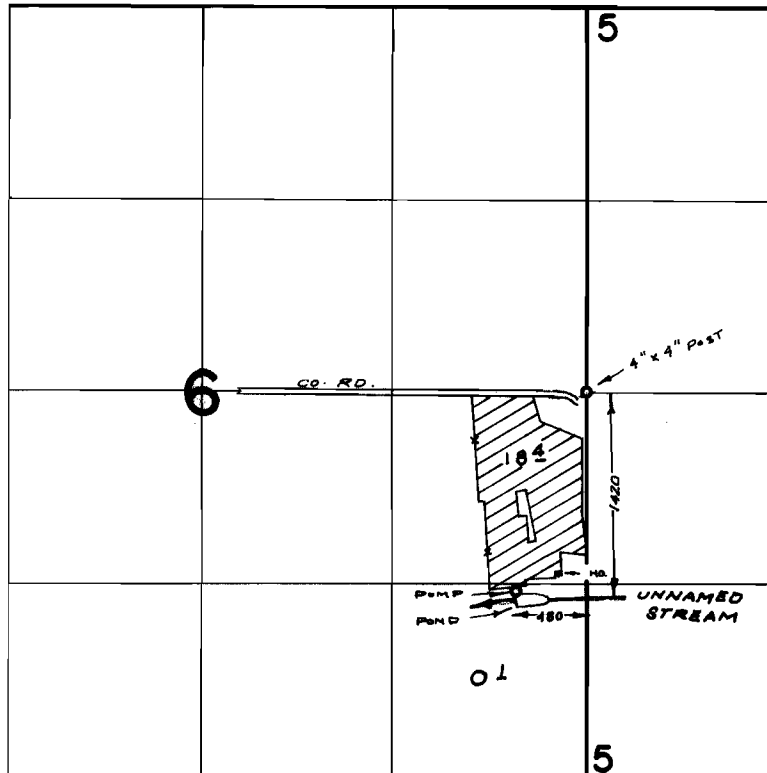

FINAL PROOF SURVEY
UNDER

Application No. 33894 Permit No. 30115
IN NAME OF

VERNON F. LAU

Surveyed MAY 29 1971, by R. MUCKEN