


T.4S.R.1E.W.M.

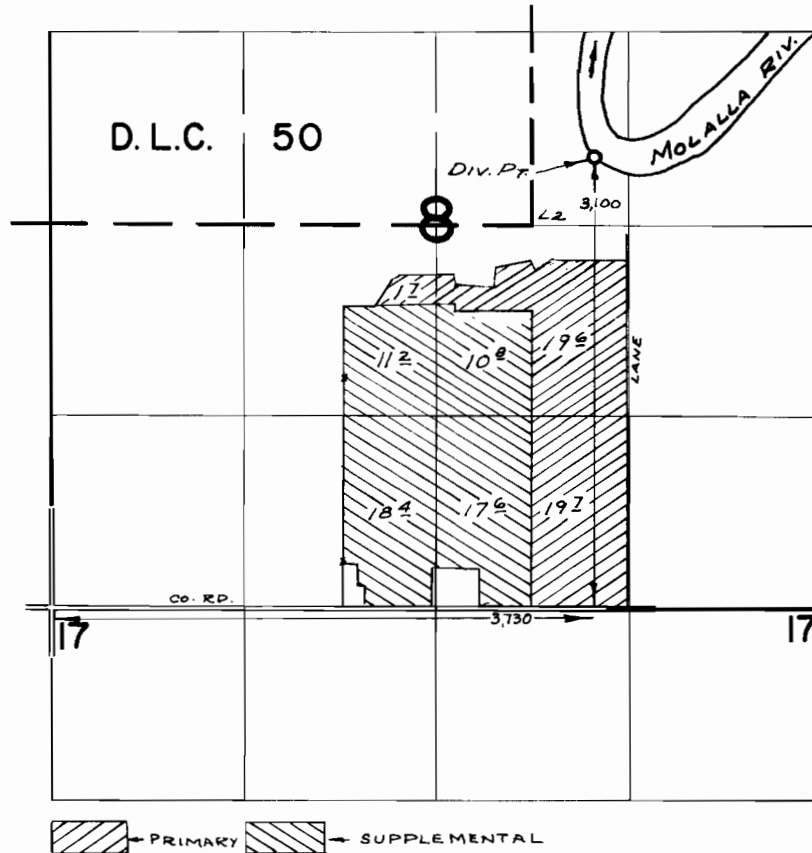

FINAL PROOF SURVEY UNDER

Application No. 41596 Permit No. 31025
IN NAME OF

P. C. McCORMICK

Surveyed Aug. 18, 1971, by R. MUCKEN