


T. 4S. R. 18 & 2E. W. M.

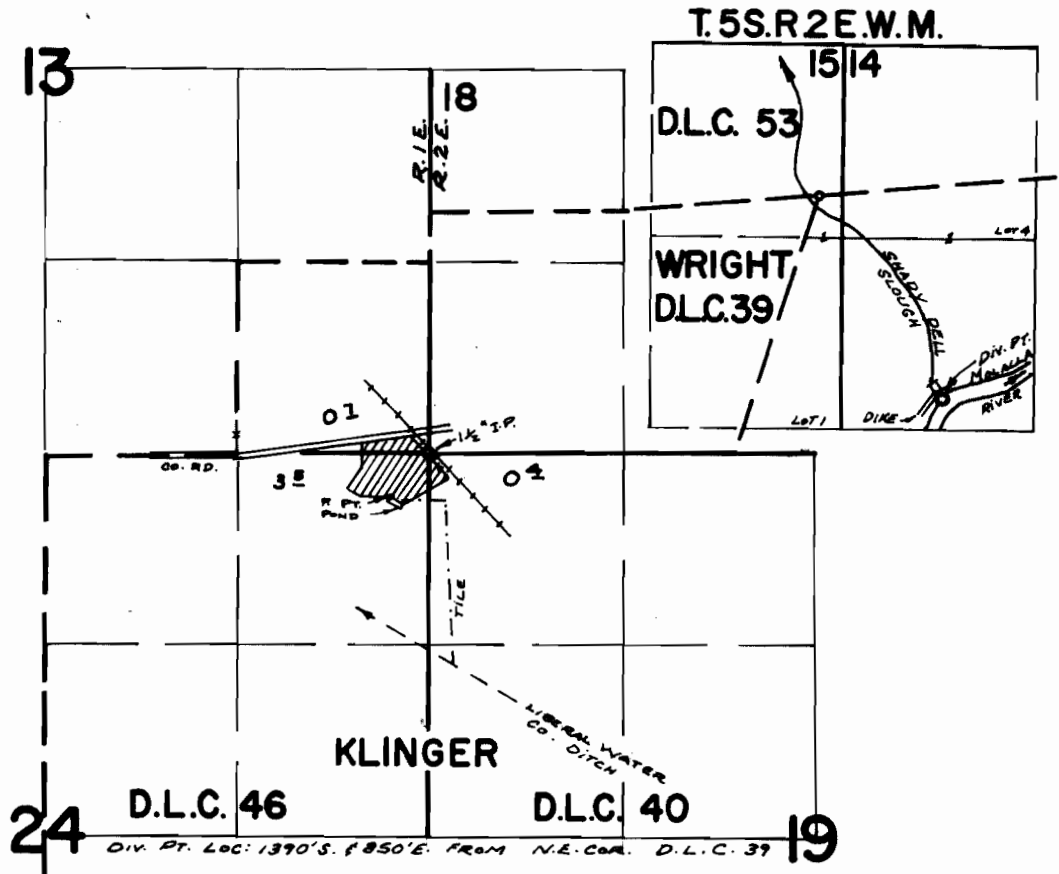

FINAL PROOF SURVEY UNDER

Application No. 42592 Permit No. 31822
IN NAME OF

FRANKLIN R. & FRANCES D. YOUNG

Surveyed Max. 18, 1971, by R. MUCKEN