


T. 2 S. R. 1 E. W. M.

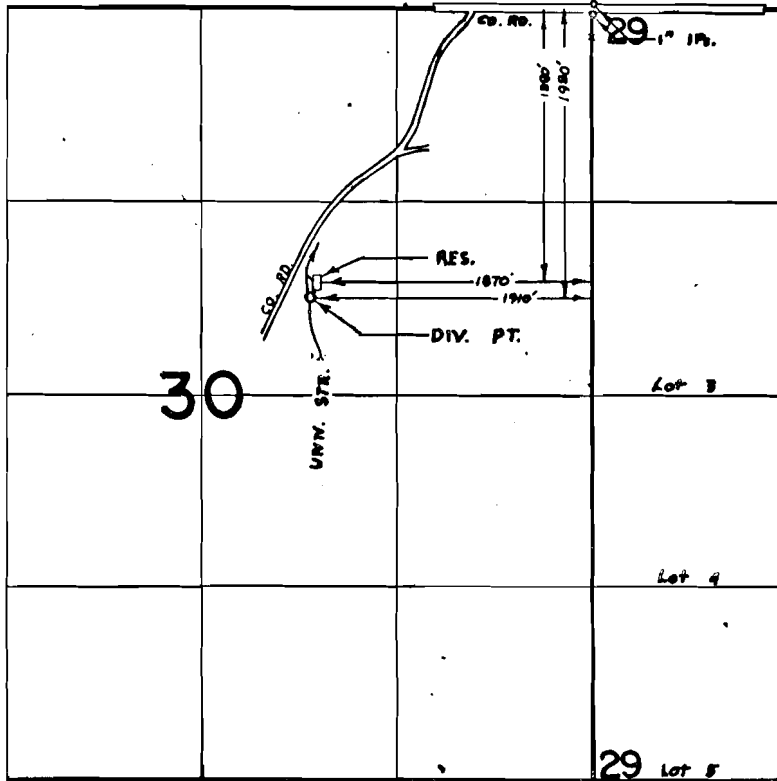

FINAL PROOF SURVEY UNDER

R-43545 R-4940
Application No.43546 Permit No.32277.
IN NAME OF

.....HUGH TATTERSALL.....

Surveyed JULY...8... 1971, by R...MUCKEN.....