


T. 2 S. R. 1 E. W. M.

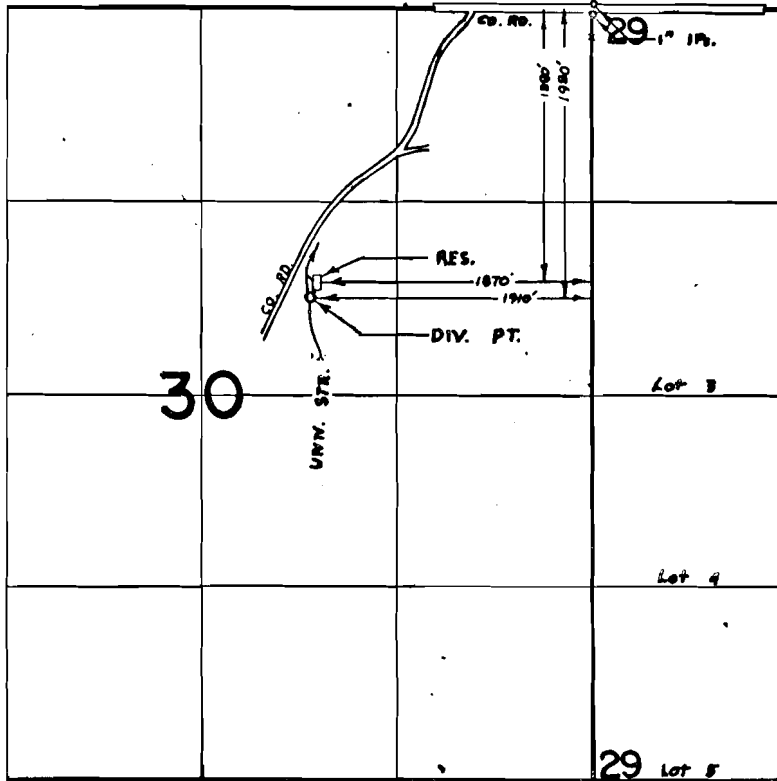

FINAL PROOF SURVEY UNDER

IN NAME OF

.....HUGH TATTERSALL.....

Surveyed JULY 8th 1971, by R. MUCKEN.....