


T.4S.R.2E.W.M.

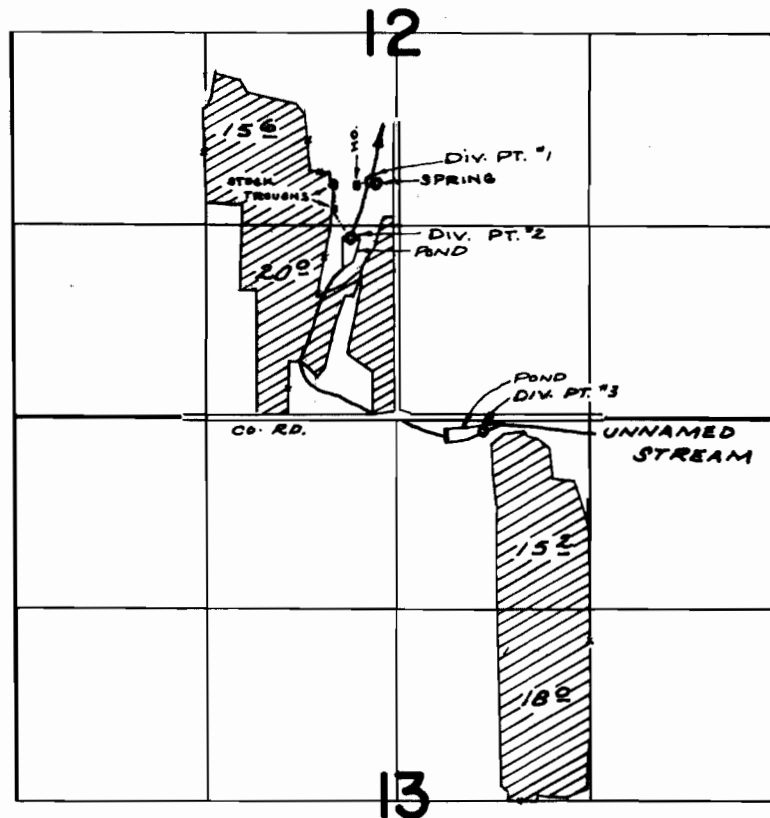

DIV. PTS. LOC: SPRING - 1620 N. & 180' W; UNN. STR. - 1620' N. & 180' W;
1230 N & 320 W; 70'S. & 600' E, ALL FROM S. 1/4 COR. SEC. 12

FINAL PROOF SURVEY
UNDER

Application No. 44179 Permit No. 33009
IN NAME OF

GARY MOSER

Surveyed Nov. 15, 1971, by R. MUCKEN