


T. 4 S. R. 1 E. W. M.

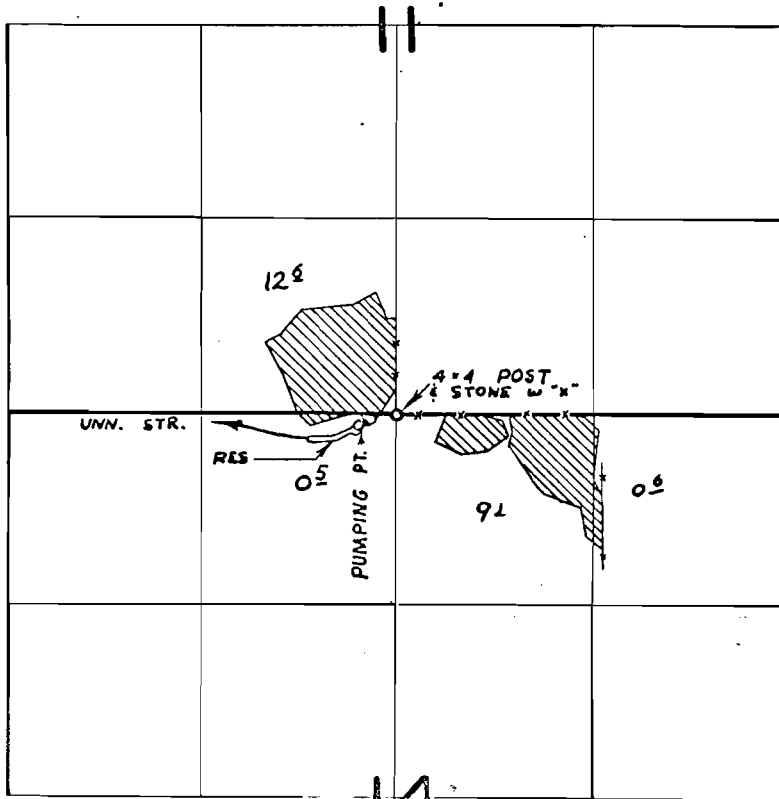

DIV. PT. LOC. 180' S & 590' W FROM N 1/4 COR. SEC. 14

FINAL PROOF SURVEY UNDER

R-44812 R-5294
Application No. 44813 Permit No. 33517
IN NAME OF

SIEGFRIED KRAXBERGER

Surveyed OCT. 8, 1971, by R. MUCKEN