


T. 6 N. R. 5 & 6 W. W. M.

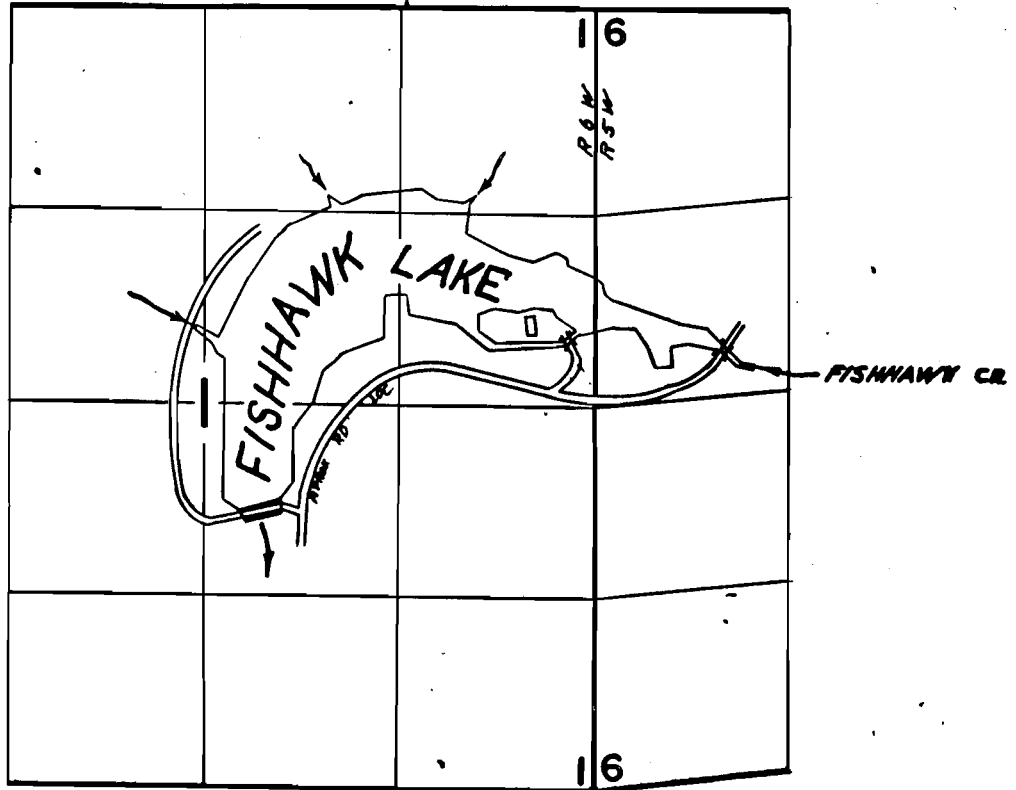

DAM LOG: FROM APPLICATION MAP

FINAL PROOF SURVEY
UNDER

R-39963 R-3982
Application No.40075. Permit No.29750.
IN NAME OF

FISHHAWK LAKE RECREATION CLUB INC.

Surveyed JUNE...8., 1971., by R...MUCKEN.....