


T. 6 N. R. 5 & 6 W. W. M.

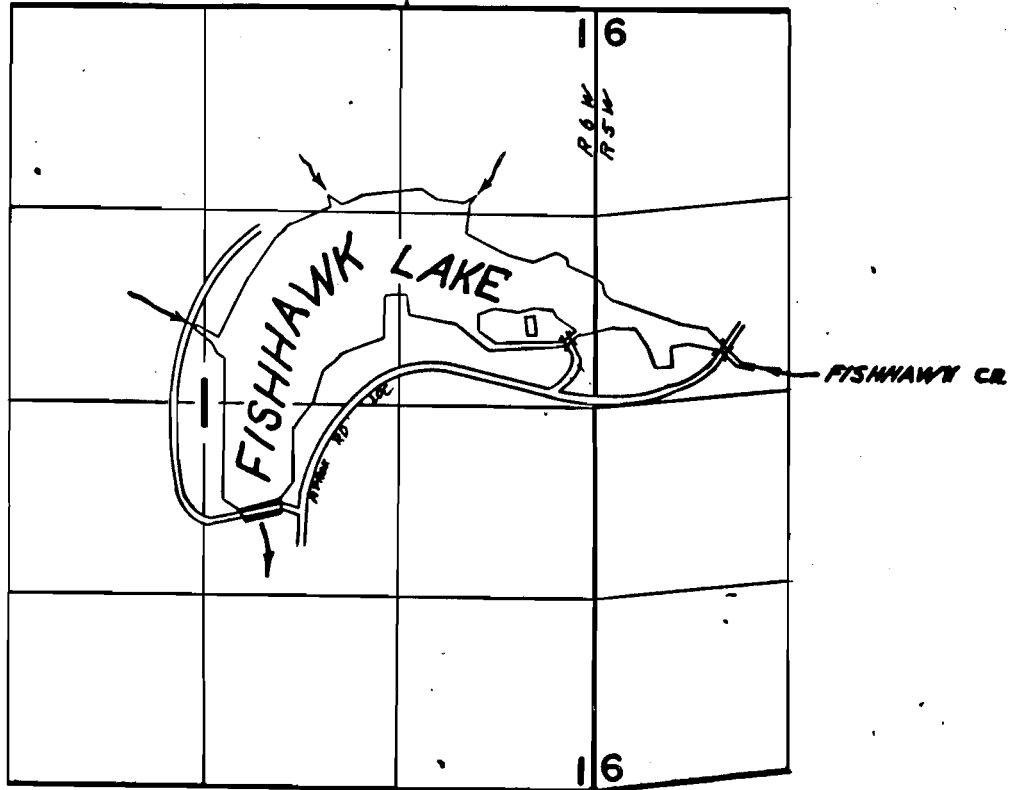

DAM LOG: FROM APPLICATION MAP

**FINAL PROOF SURVEY**  
UNDER

R-39963                      R-3982  
Application No. ....40075. Permit No. ....29750.  
IN NAME OF

*FISHHAWK LAKE RECREATION CLUB INC.*

Surveyed JUNE...8., 1971., by R...MUCKEN.....