T. 27 S. R. 5 & 6 W. W. M.

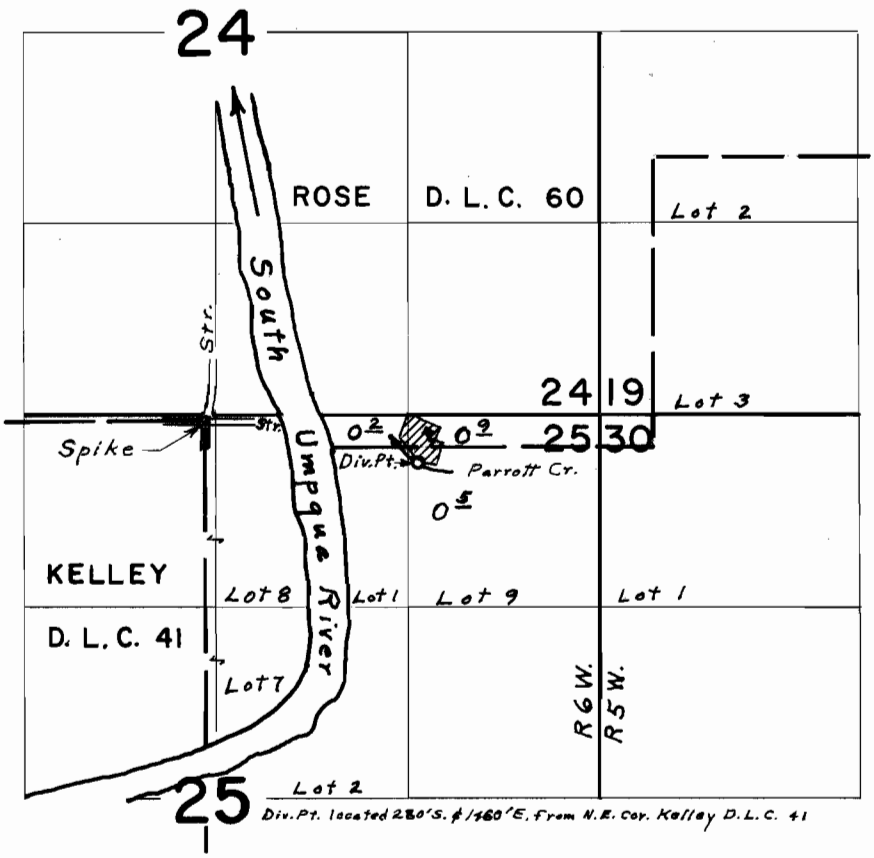

FINAL PROOF SURVEY
UNDER

Application No. 40491 Permit No. 30172
IN NAME OF

LEONARD D. & ANABEL Q. GRENSKY

Surveyed April 13, 1971, by L. E. Gould

1971-S