


T. 28 S. R. 7 W. W.M.

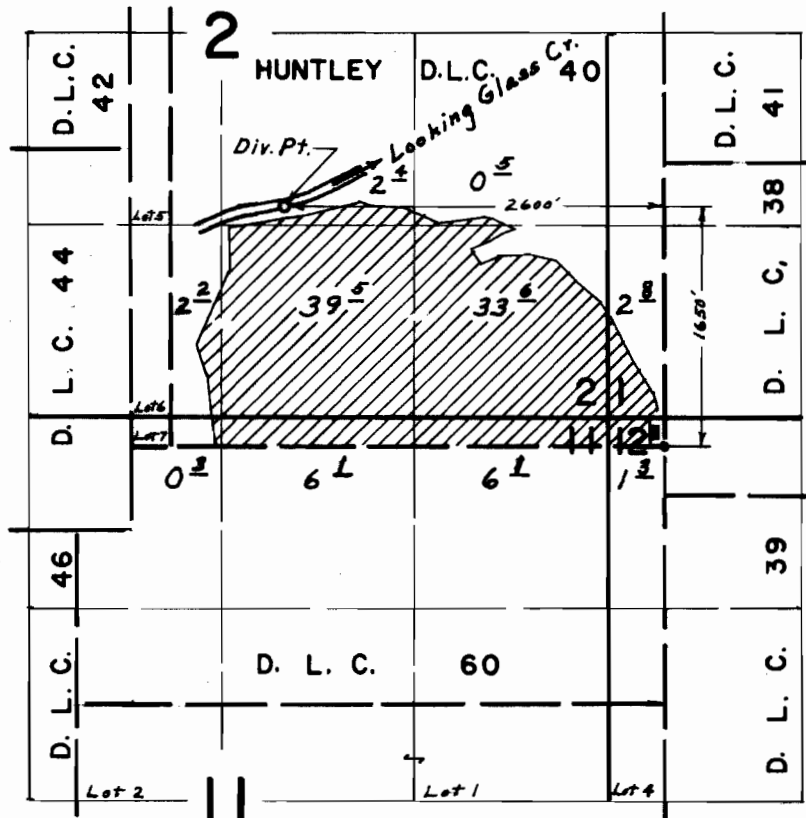

FINAL PROOF SURVEY UNDER

Application No. 43467 Permit No. 32511
IN NAME OF

DONALD B. & H. B. KRUSE

Surveyed April 14, 1971, by L. E. Gould.