


T. 27 S. R. 6 W. W. M.

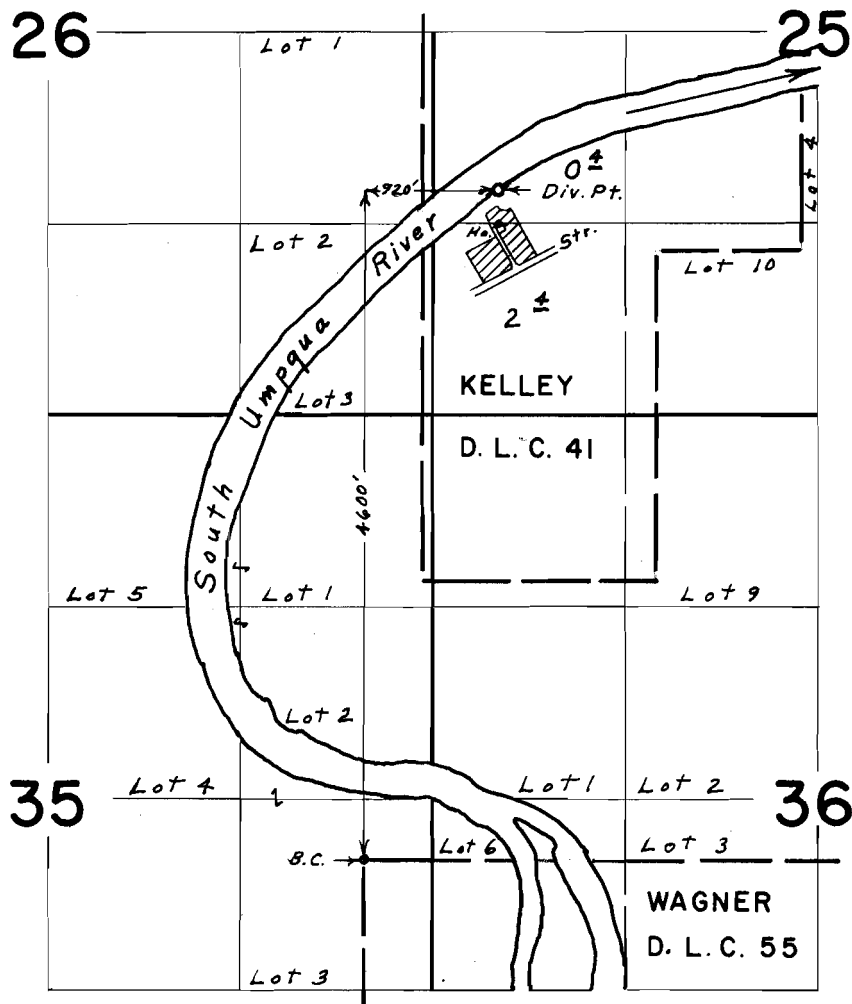

**FINAL PROOF SURVEY**  
UNDER

Application No. 43633 Permit No. 32621  
IN NAME OF

JAMES W. STEWART

Surveyed April 12, 1971, by L. E. Gould