


P. 26 987

6

55743  
38694

# T 11 S. R. 34 & 35 E. W. M.

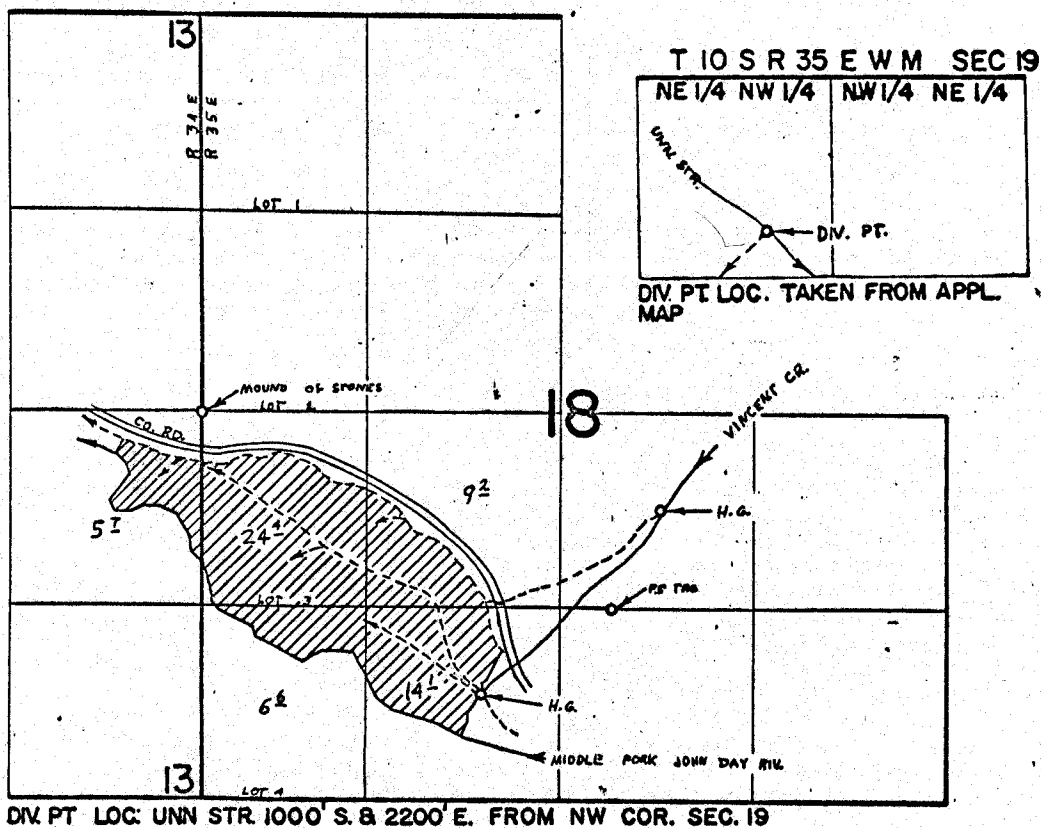

## FINAL PROOF SURVEY UNDER

Application No. 34339..... Permit No. 26987.....  
IN NAME OF

ORRIN FORREST

Surveyed AUG. 27, 1971, by R. MUCKEN.....