




P-28480
38695 6

T.9S.R.26E.W.M.

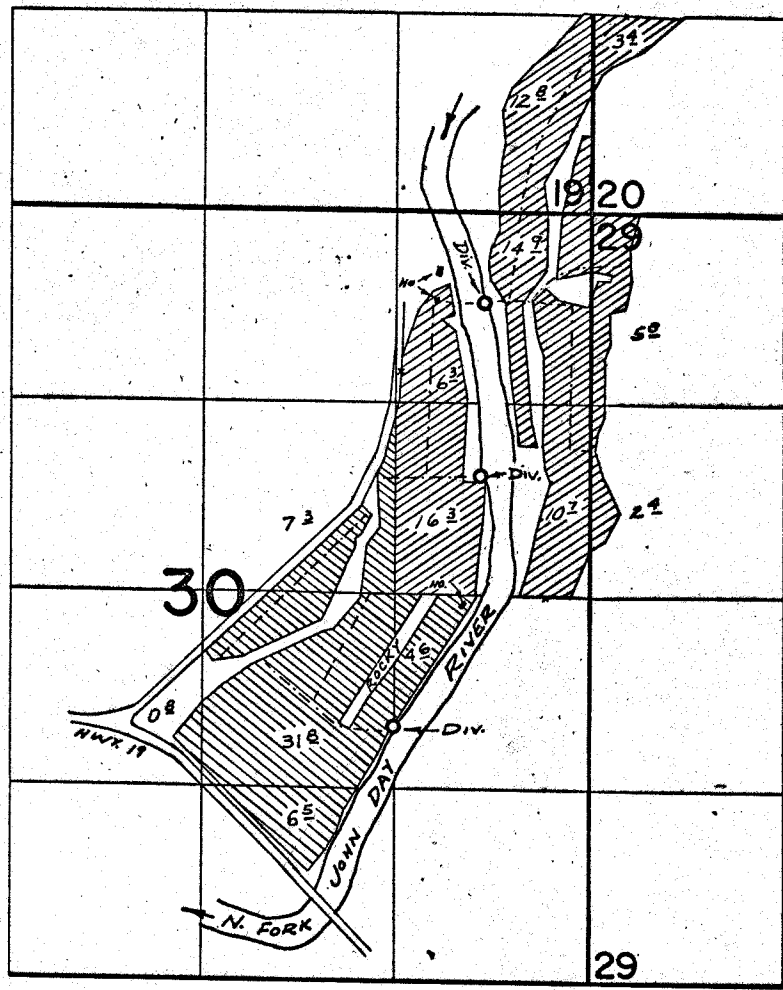

 APPL. 38224  APPL. 43440
 DIV. PTS. ARE: 620'S. & 750'W.; 1800'S. & 750'W.; 3510'S. & 1330'W.;
 ALL FROM N.E. COR. SEC. 30

FINAL PROOF SURVEY UNDER

Application No. 38224 ~~43440~~ Permit No. 28480 ~~32495~~
 IN NAME OF
THOMAS ORCHARDS, INC.
 Surveyed July 17, 1971, by R. MURKIN