


32099

38698

6

T. 7 S. R. 31 E. W. M.

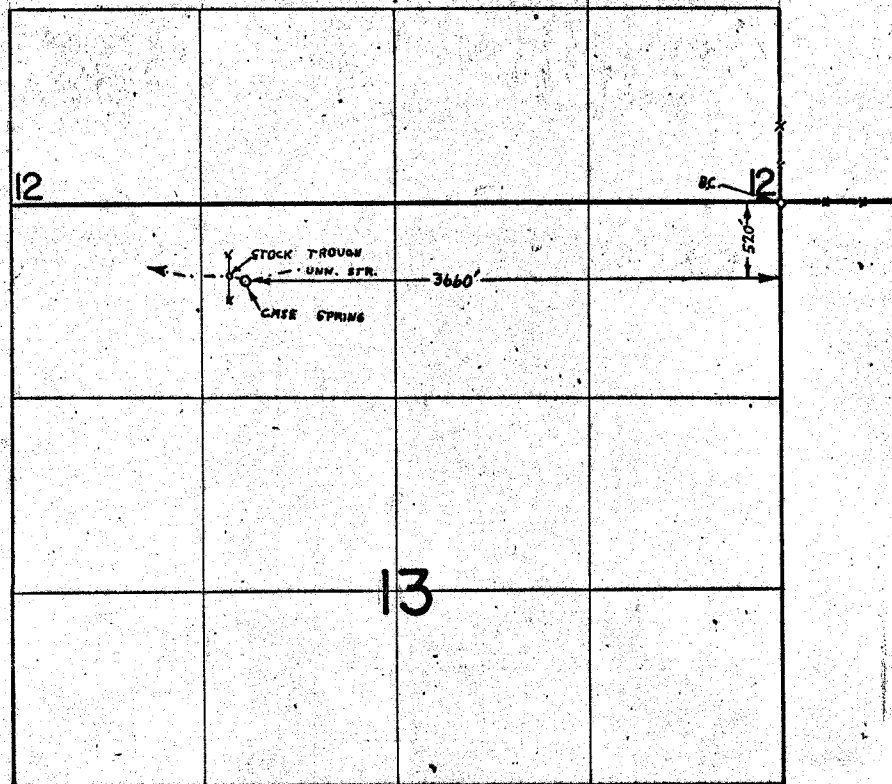

FINAL PROOF SURVEY
UNDER

Application No. 42965 Permit No. 32099
IN NAME OF

ELMER ARBOGAST

Surveyed AUG. 25, 1971, by R. MUCKEN