


T.9S.R.26E.W.M.

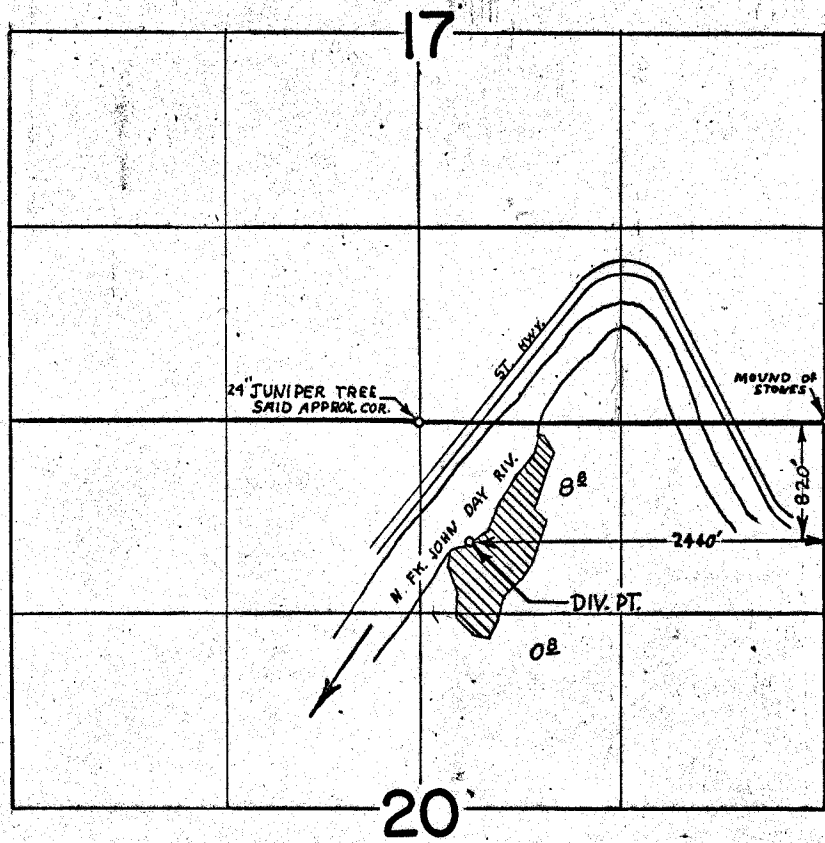

FINAL PROOF SURVEY UNDER

Application No. 43208 Permit No. 31952
IN NAME OF

EDWARD KILBY

Surveyed JULY 21, 1971, by R. MUCKEN