


34926

38700 6

T.9S.R.26E.W.M.

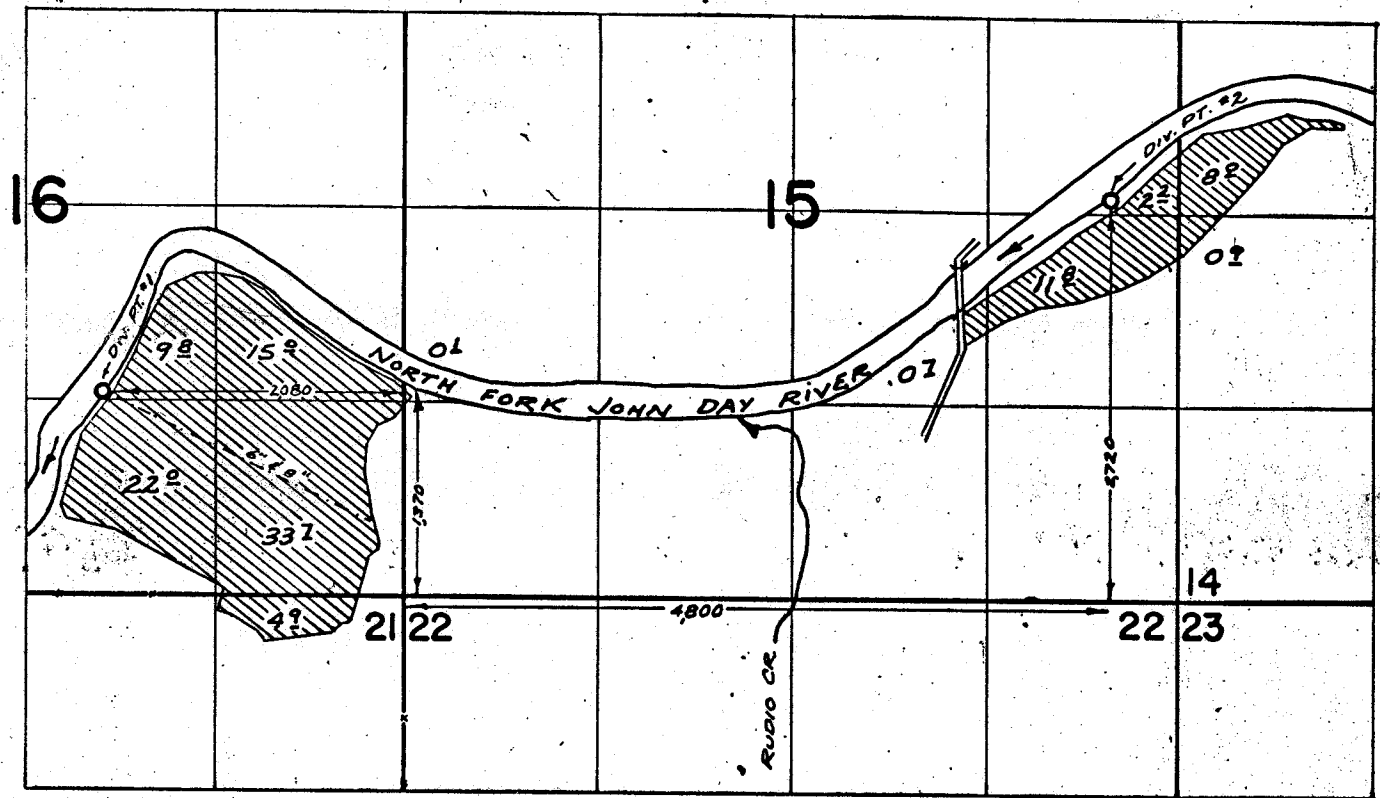

FINAL PROOF SURVEY UNDER

Application No. 46768 Permit No. 34926
IN NAME OF

CAMPBELL LIVESTOCK COMPANY

Surveyed July 13, 1971, by R. MURKIN