


T. 3 4 S. R. 1 W. W. M.

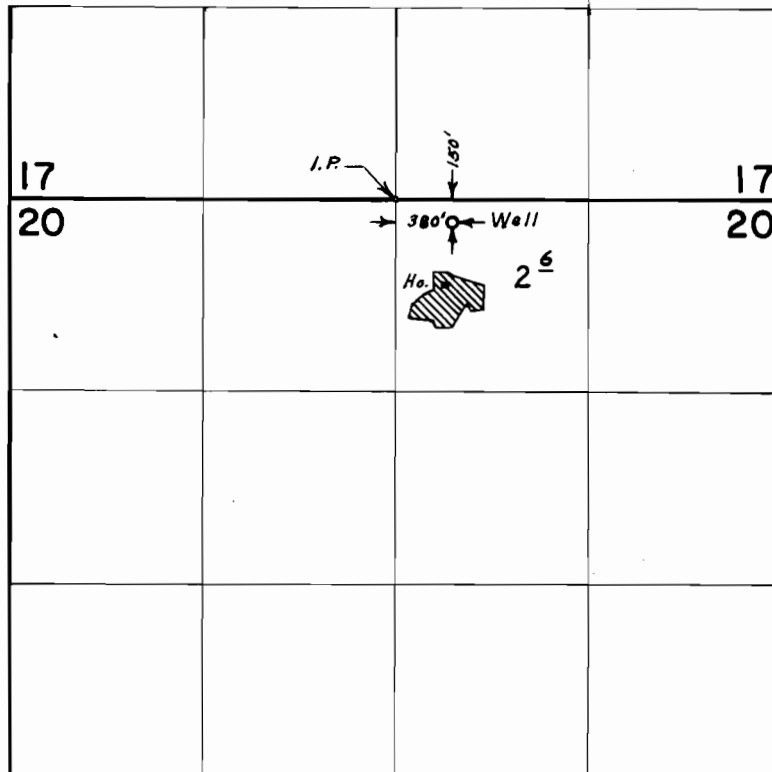

FINAL PROOF SURVEY UNDER

Application No. G-3271 Permit No. G-3066
IN NAME OF

JOE H. RHODES

Surveyed May 5, 1971, by L. E. Gould