


G-3611 14  
38702

# T.41S.R.10E.W.M.

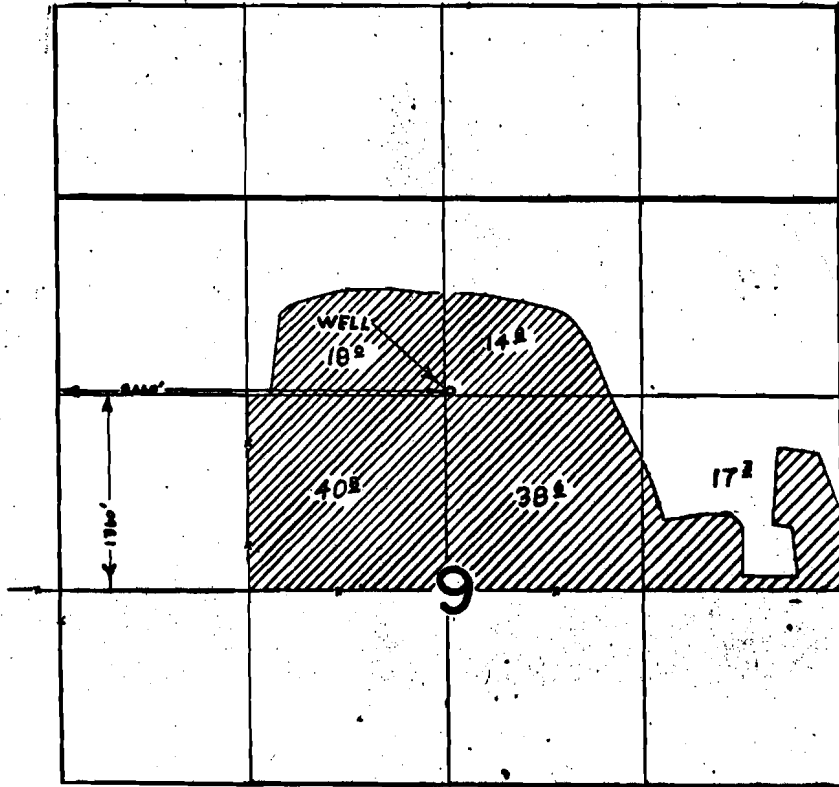

East River wells

## FINAL PROOF SURVEY UNDER

Application No. G.3831 Permit No. G.361  
IN NAME OF

WALTER W. & JOSEPH C. FOTHERINGHAM

Surveyed SEP. 15. 1971, by R. MUCKEN