
27966
30705

T.37S.R.12E.W.M.

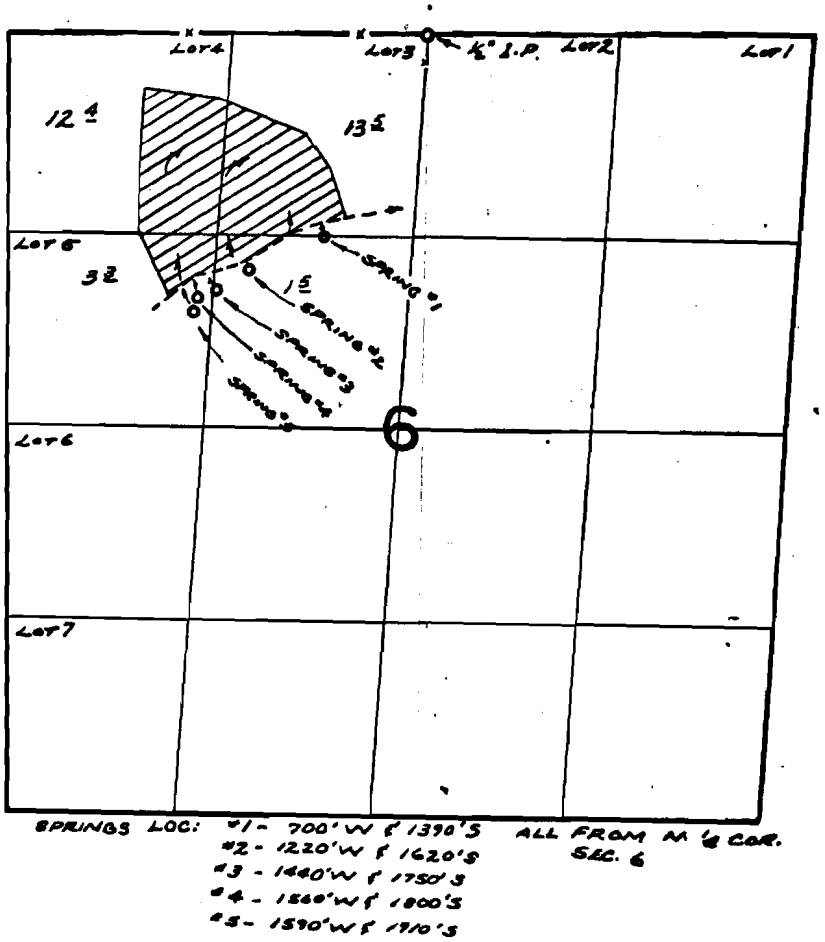

Whiskey Creek : Misc.

FINAL PROOF SURVEY
UNDER

Application No. 37527 Permit No. 27966
IN NAME OF

MIKE DEELY

Surveyed May 15 19 70, by R. MUCKEN

1970-K