


# T. 10 S. R. 1 W. W. M.

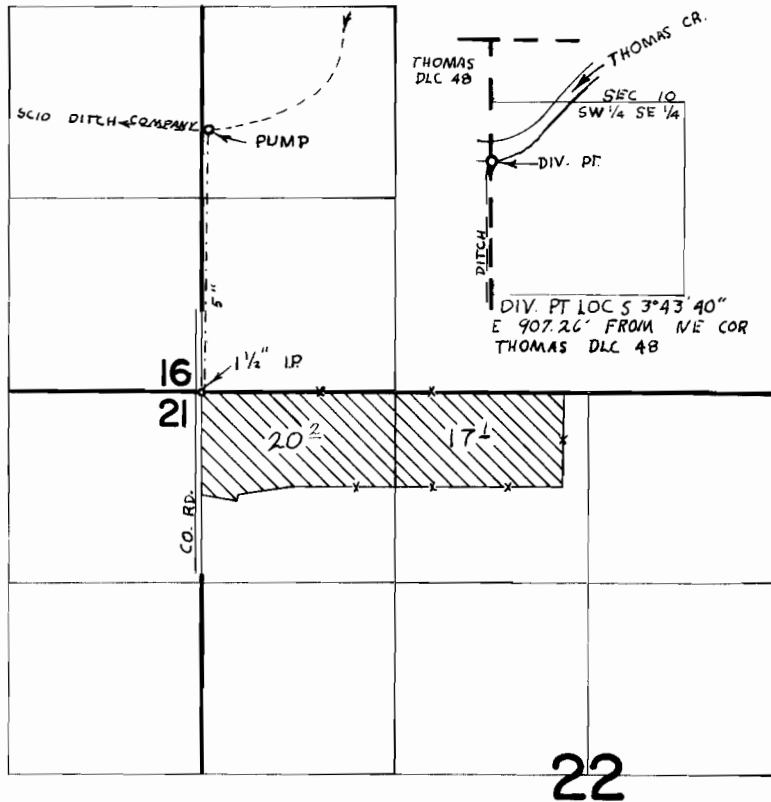

## FINAL PROOF SURVEY UNDER

Application No. 46897 Permit No. 34944  
IN NAME OF

*JACK and VERA SMALLEY*

Surveyed SEP. 10, 1971, by R. MUCKEN