


T. 7 S. R. 2 W. W. M.

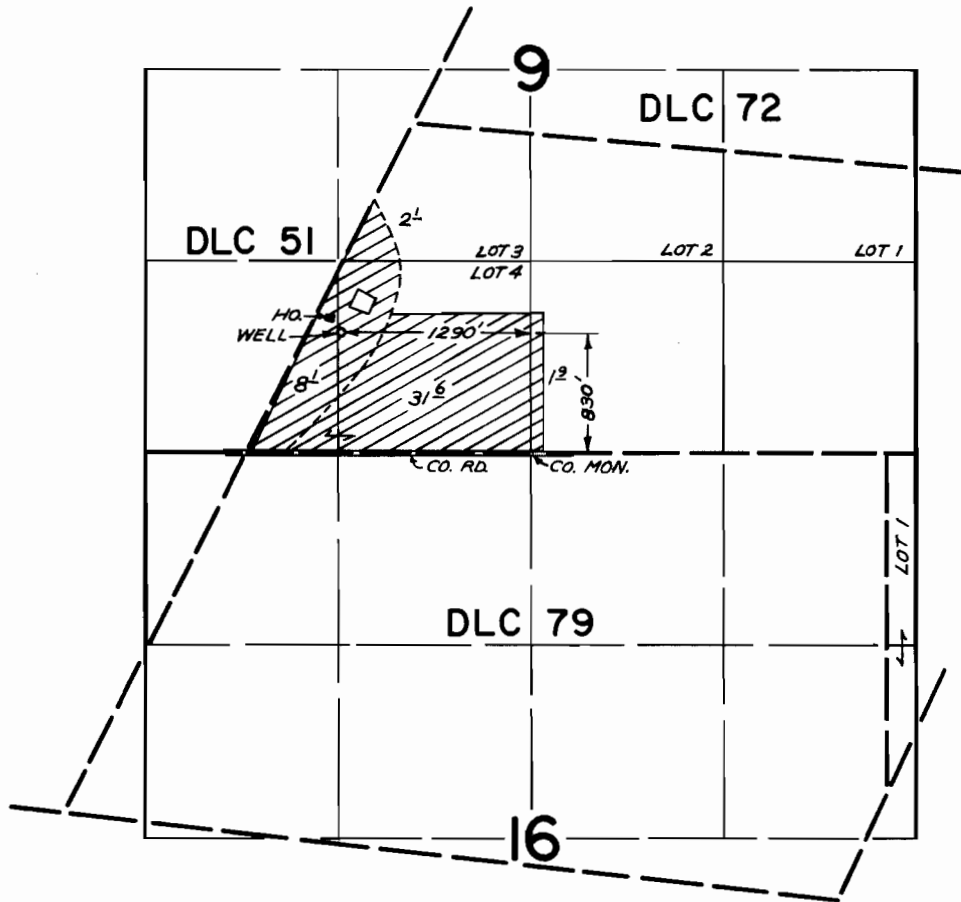

FINAL PROOF SURVEY
UNDER

Application No. G-3520 Permit No. G-3312
IN NAME OF

H. C. TOELLE

Surveyed MAY 19 1971, by GREG BACA