


T. 7 S. R. 2 W. W. M.

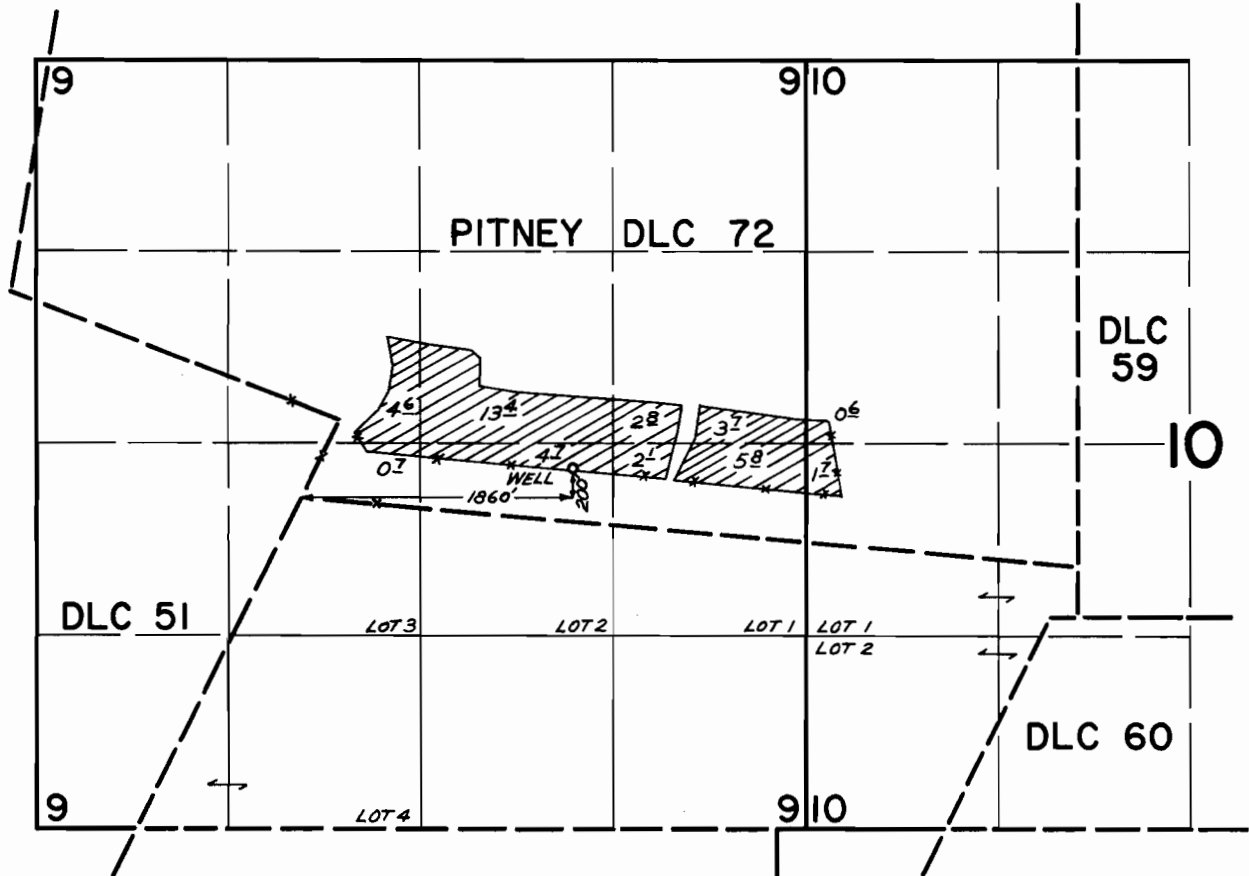

FINAL PROOF SURVEY
UNDER

Application No. *G-3524* Permit No. *G-3316*
IN NAME OF

B. E. NANNEMAN

Surveyed *MAY 19* 1971, by *GREG BACA*