


T. 8 S. R. 3 W. W. M.

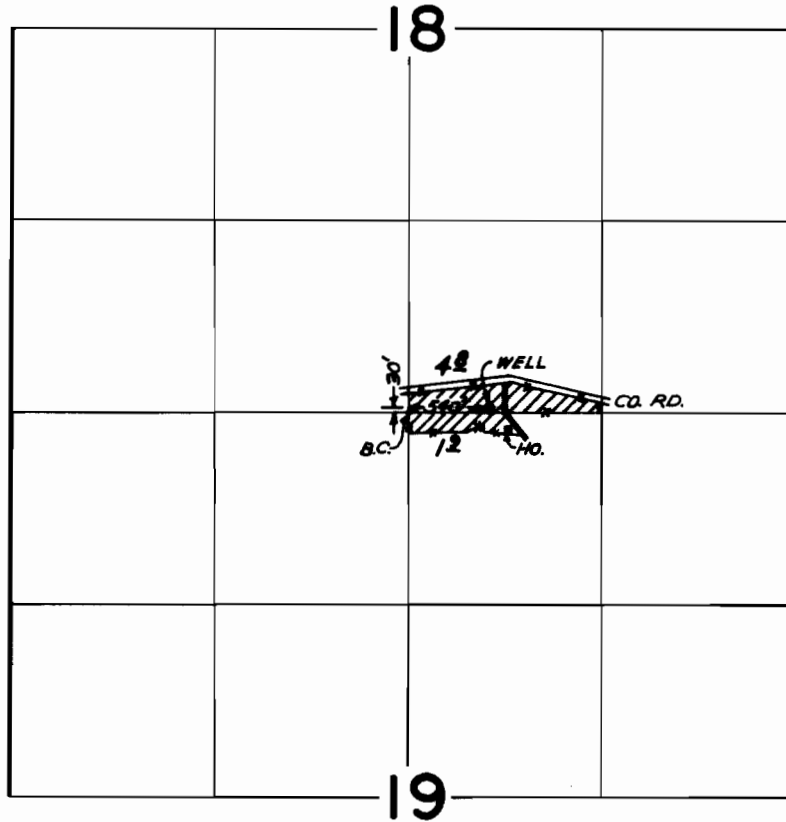

FINAL PROOF SURVEY
UNDER

Application No. G-4375 Permit No. G-4127
IN NAME OF

CHARLES J. & GENEVIEVE L. RYBLOOM

Surveyed APR. 29 1971, by GREG BACA