


# T.1&2N.R.25E.W.M.

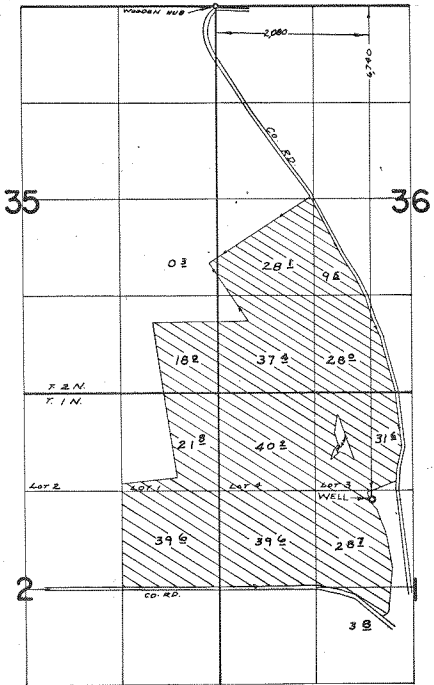

## FINAL PROOF SURVEY UNDER

Application No. G-3012 Permit No. G-2221  
 IN NAME OF  
**LAWRENCE D. & CORRINE LINDSAY**  
 Surveyed JUNE 29 1971, by R. MUCKEN