


G-3712
38712

T.I.S.R.26E.W.M.

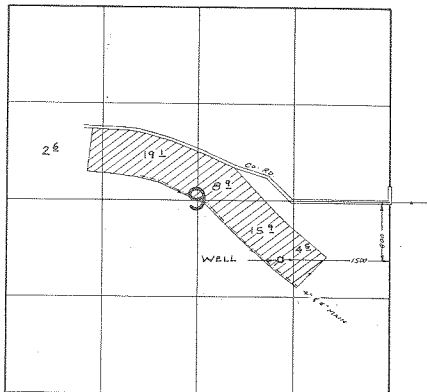

FINAL PROOF SURVEY UNDER

Application No. G-3065 Permit No. G-3012
IN NAME OF

GENE CUTSFORTH

Surveyed MAY 12 1971, by R. MUCKEN

1971-K