


T. 4 N. R. 25 E. W. M.

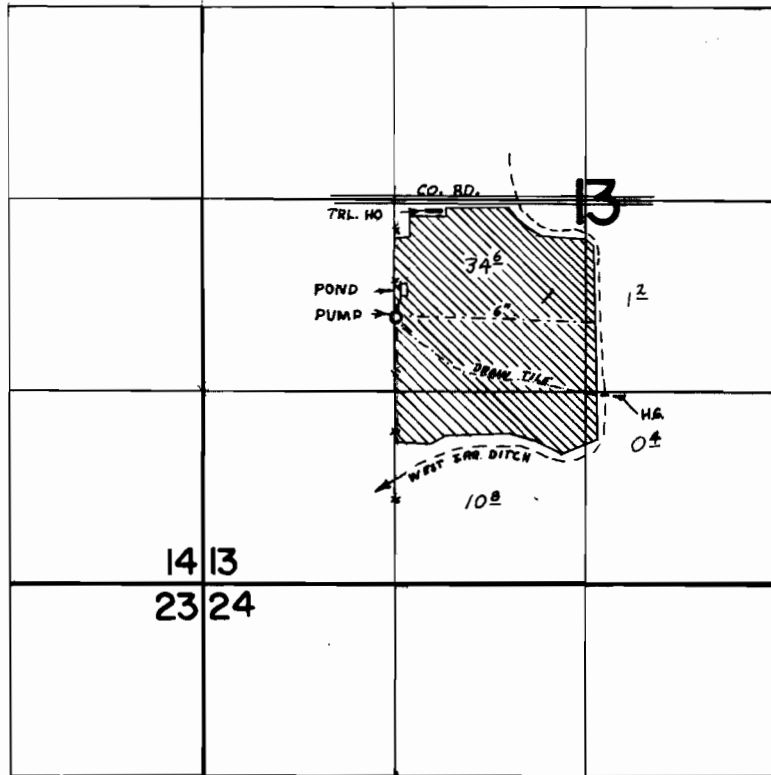

TILE DRAIN LOC. 810' S. 10' E FROM NW COR. NE 1/4 SW 1/4 SEC. 13

FINAL PROOF SURVEY UNDER

Application No. G-3437 Permit No. G-3231
IN NAME OF

HILLVIEW DAIRY INC.

Surveyed JULY 1, 1971, by R. MUCKEN