


T. 1 & 2 N. R. 27 E. W. M.

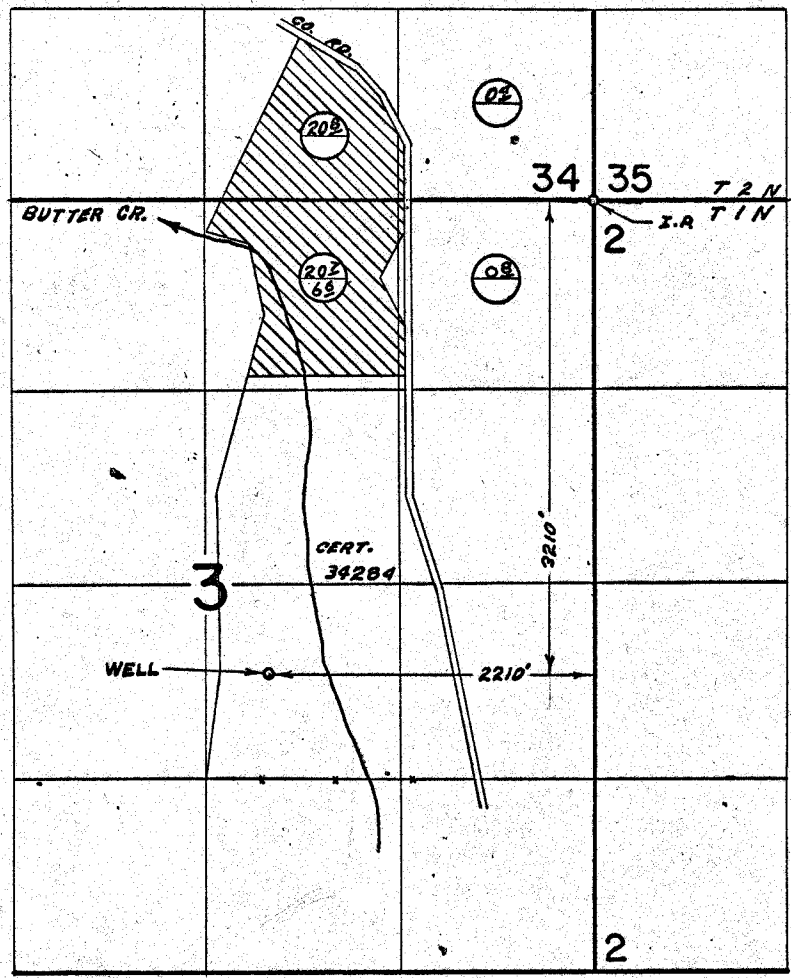

⊖ SUPPLEMENTAL
 ⊙ PRIMARY

FINAL PROOF SURVEY UNDER

Application No. G-3442 Permit No. G-3101
 IN NAME OF

EDWARD B. WATTENBURGER

JUNE 24, 1966 by L. GOULD
 Surveyed JULY 1, 1971, by R. MUCKEN