


G-3112
387157

T.3S.R.25E.W.M.

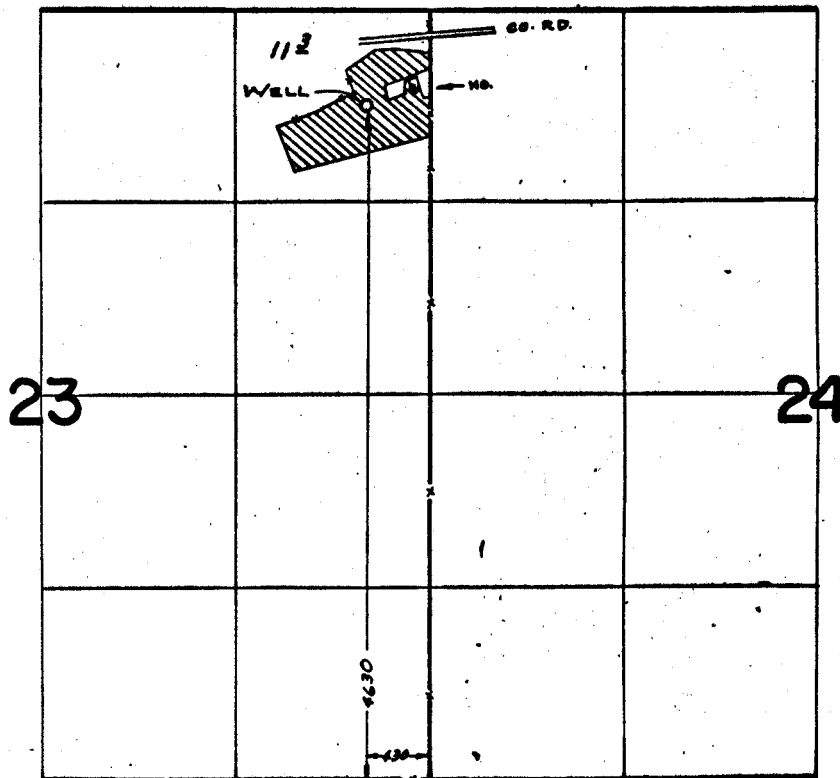

FINAL PROOF SURVEY
UNDER

Application No. G-3448 Permit No. G-3272
IN NAME OF

HAZEL MAHONEY

Surveyed MAY 10, 1971, by R. M. MARR