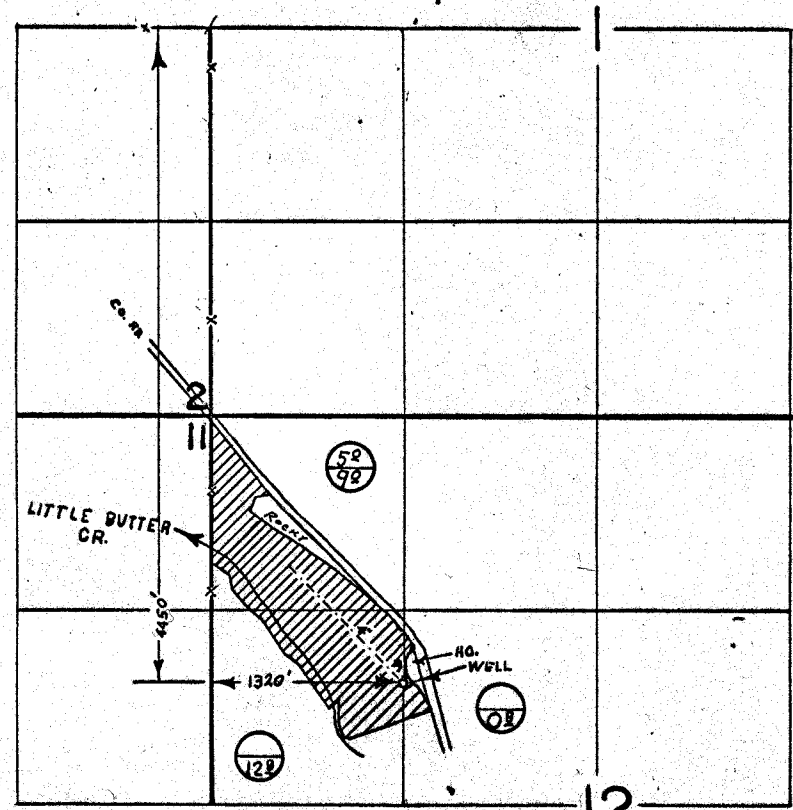

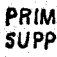


T2S.R.28E.W.M.



 PRIMARY
 SUPPLEMENTAL

FINAL PROOF SURVEY UNDER

Application No. G-4134... Permit No. G-3886...
IN NAME OF

.....ALLEN HUGHES.....

Surveyed JUNE 25, 1971... by R. MUCKEN.....