


T.1S.R.24E.W.M.

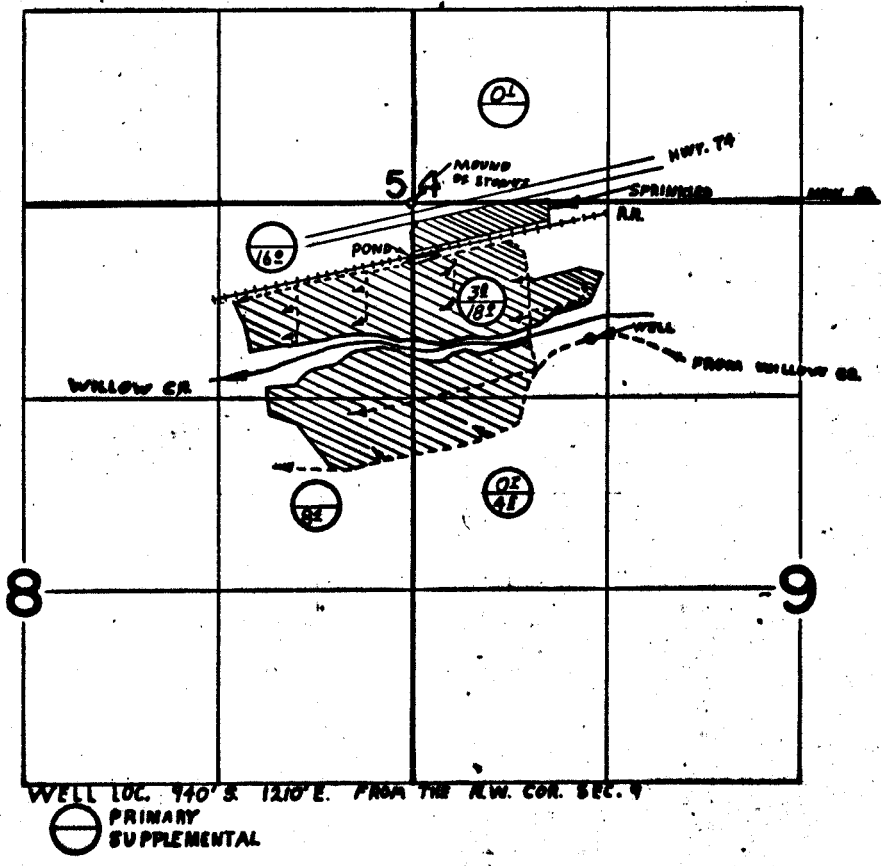

FINAL PROOF SURVEY UNDER

Application No. G-4589 Permit No. G-4316
 IN NAME OF
HEBERT R. & PANSY MAY EKSTROM
 Surveyed JUNE 25, 1971, by R. MUCKEN