
G-4519

38720

T.1N.R.23E.W.M.

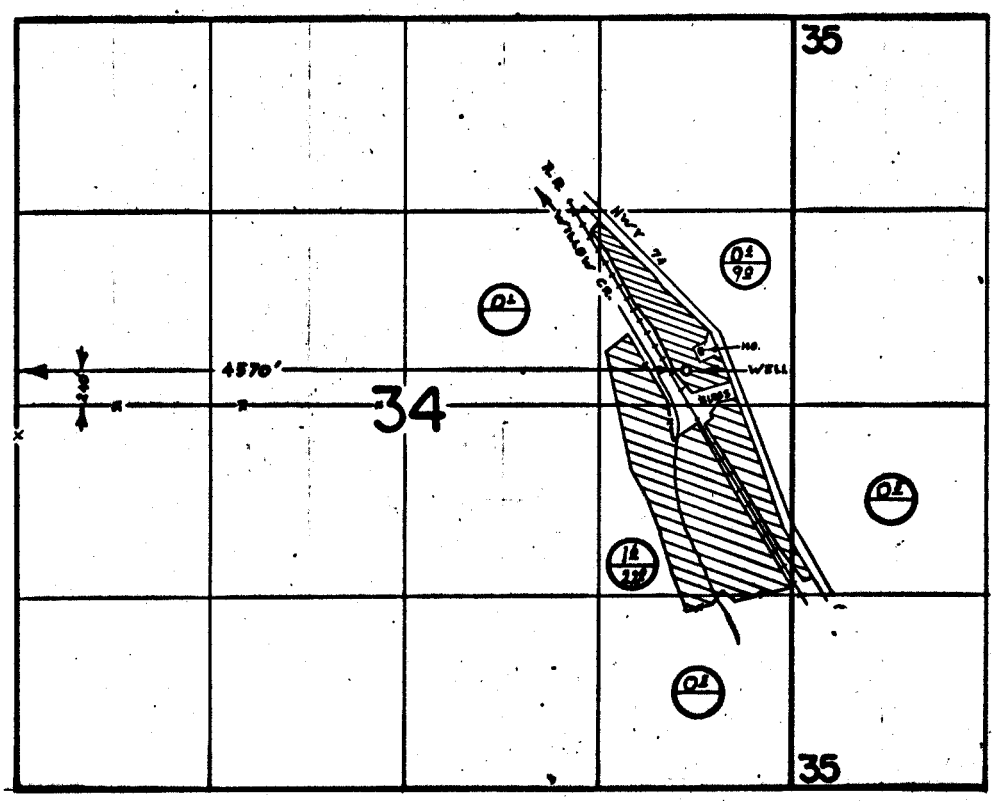

⊖ PRIMARY
SUPPLEMENTAL

FINAL PROOF SURVEY
UNDER

Application No. G-4794 Permit No. G-4519
IN NAME OF

JAMES & MARY LINDSAY

Surveyed JUNE 24, 1971, by R. MUCKEN

DJR
1971