


K-5596
38721 7

T. 4 S. R. 28 E. W. M.

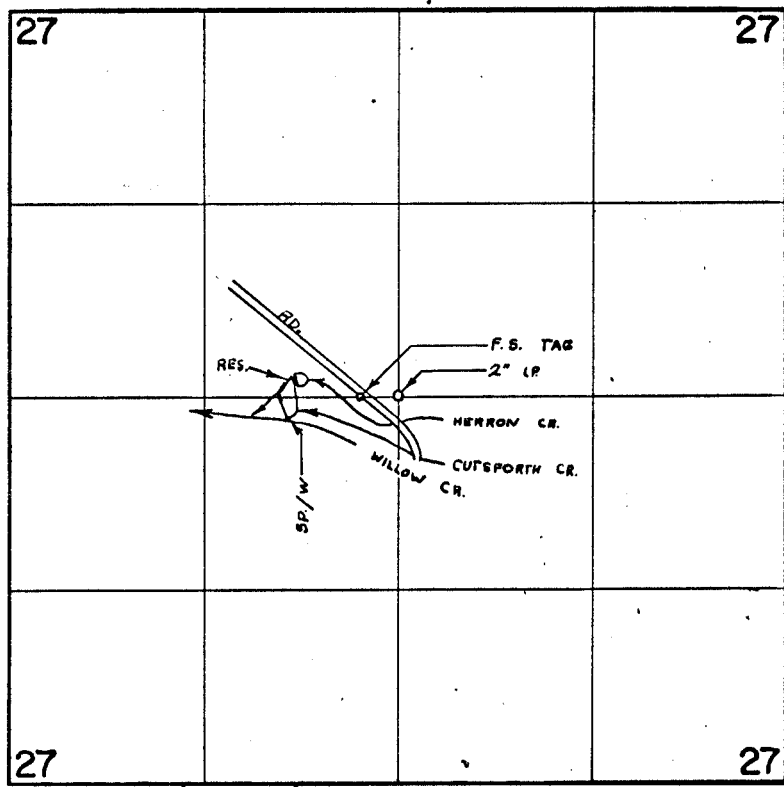

DIV. PT. LOC. 30' N. & 820' W. FROM CEN. SEC. 27

FINAL PROOF SURVEY UNDER

Application No. R 45668 45669 Permit No. R 5396 34055
IN NAME OF

MORROW COUNTY

Surveyed MAY 5 1971, by R. MUCKEN