


T. 4 S. R. 28 E. W. M.

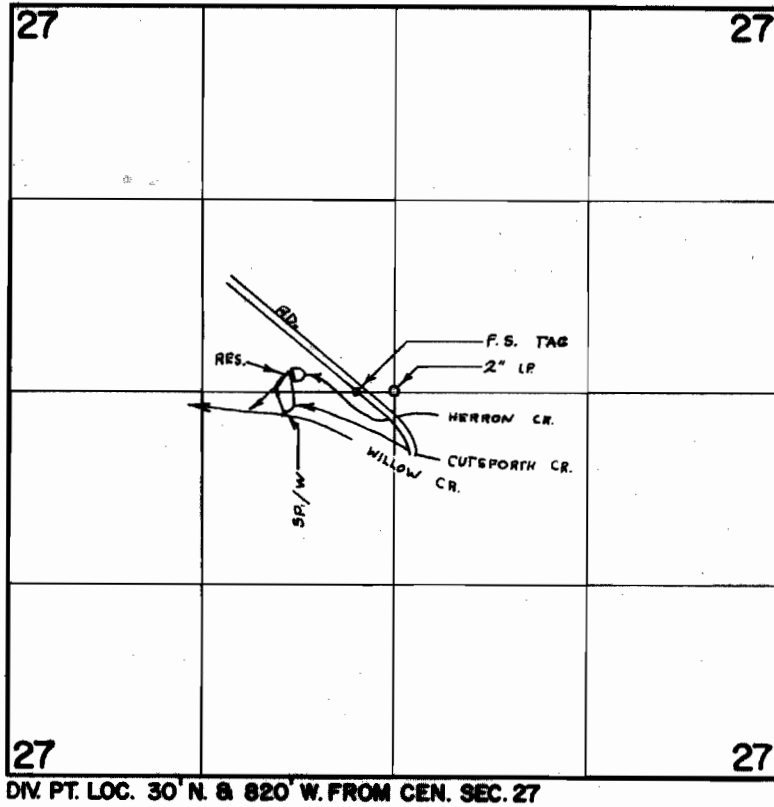

FINAL PROOF SURVEY UNDER

R 45668 R 5396
Application No. 45669 Permit No. 34055
IN NAME OF

MORROW COUNTY

Surveyed MAY 5, 1971, by R. MUCKEN