


T. 5 S. R. 25 E. W. M.

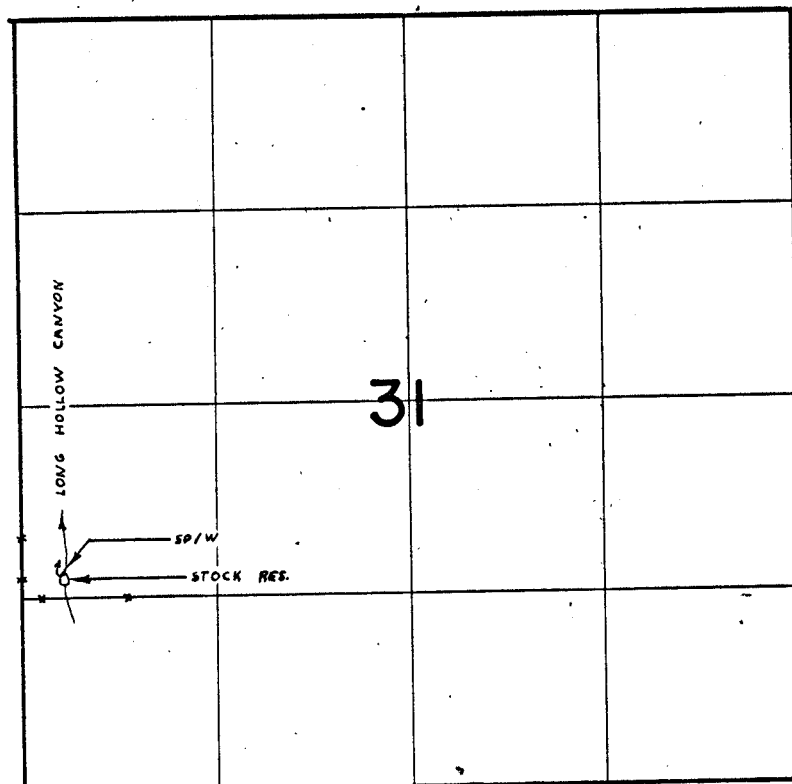

DAM LOC. 160' N. & 300' E. FROM SW COR. NW 1/4 SW 1/4 SEC. 31

FINAL PROOF SURVEY
UNDER

Application No. R. 41287... Permit No. R. 4645...
IN NAME OF

.....HORSESHOE HEREFORD RANCH.....

Surveyed MAY 8, 1971, by R. MUCKEN.....