


T. 4 S. R. 25 E. W. M.

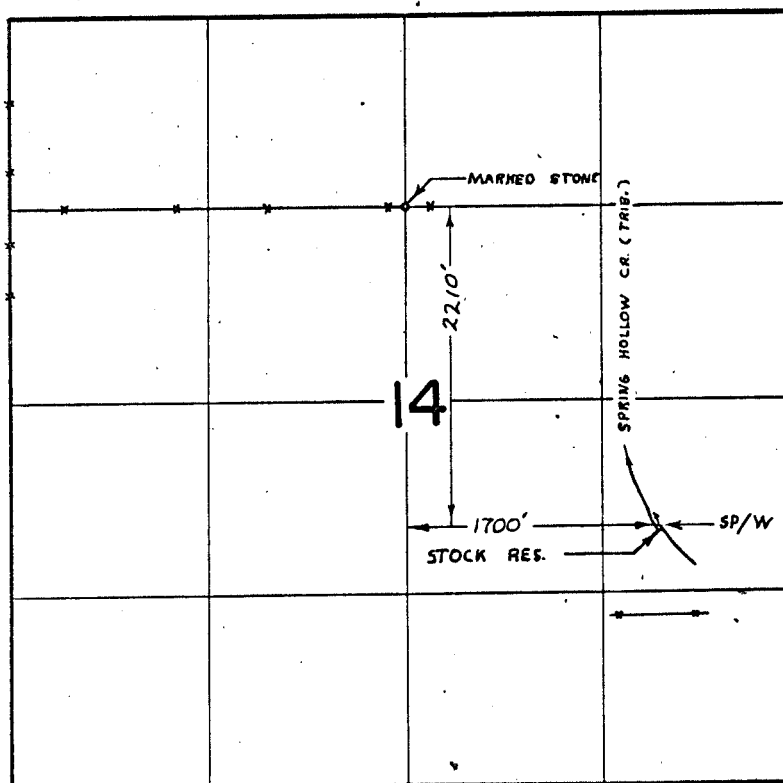

FINAL PROOF SURVEY
UNDER

Application No. R. 41288 Permit No. R. 4646
IN NAME OF

HORSESHOE HEREFORD RANCH

Surveyed MAY 8, 1971, by R. MUCKEN