


T.IN.R.IOW.W.M.

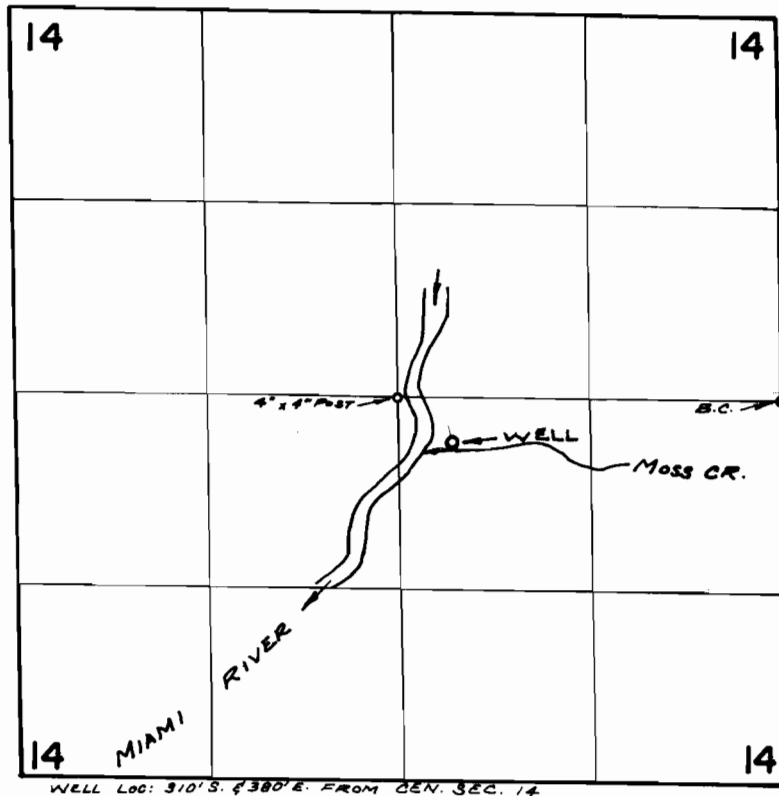

FINAL PROOF SURVEY UNDER

Application No. G-3787 Permit No. G-3719
IN NAME OF

CITY OF GARIBALDI

Surveyed AUG. 3, 1971, by R. MUCKEN.