




T.1S.R9W.W.M.

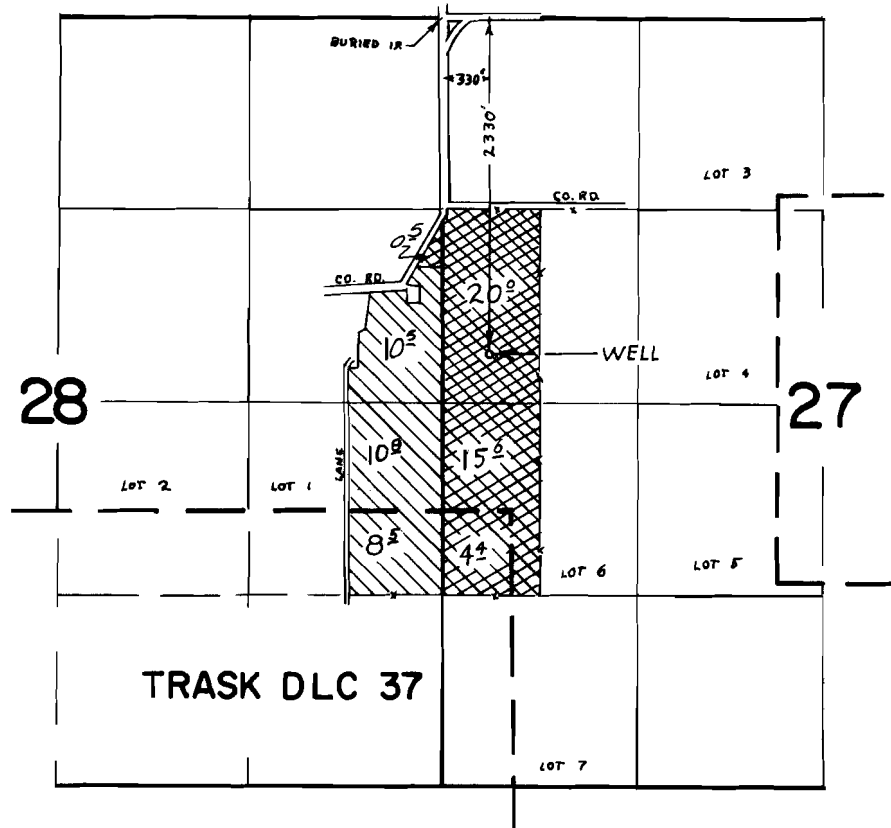

 Lands irrigated under permit G-3925  
 Lands irrigated under Cert. GR-226

**FINAL PROOF SURVEY**  
UNDER

Application No. G-4176... Permit No. G-3925...  
IN NAME OF

VIRGIL & ORELLA CHADWICK

Surveyed .AUG. 2, 1971., by .R. MUCKEN.....