


# T. I N. R. I O W. W. M.

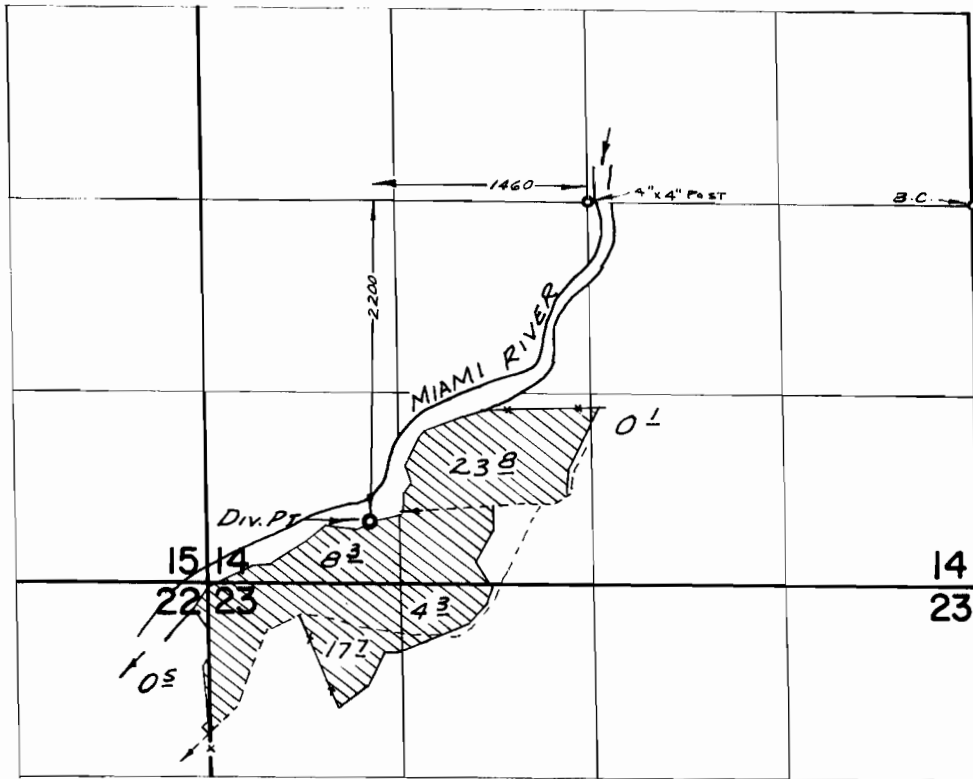

## FINAL PROOF SURVEY UNDER

Application No. 41861 Permit No. 31322  
IN NAME OF

J. A. W. & MARGARET C. SMITH

Surveyed Aug. 4, 1971, by R. MUCKEN