


T 2 N. R. 32 E. W. M.

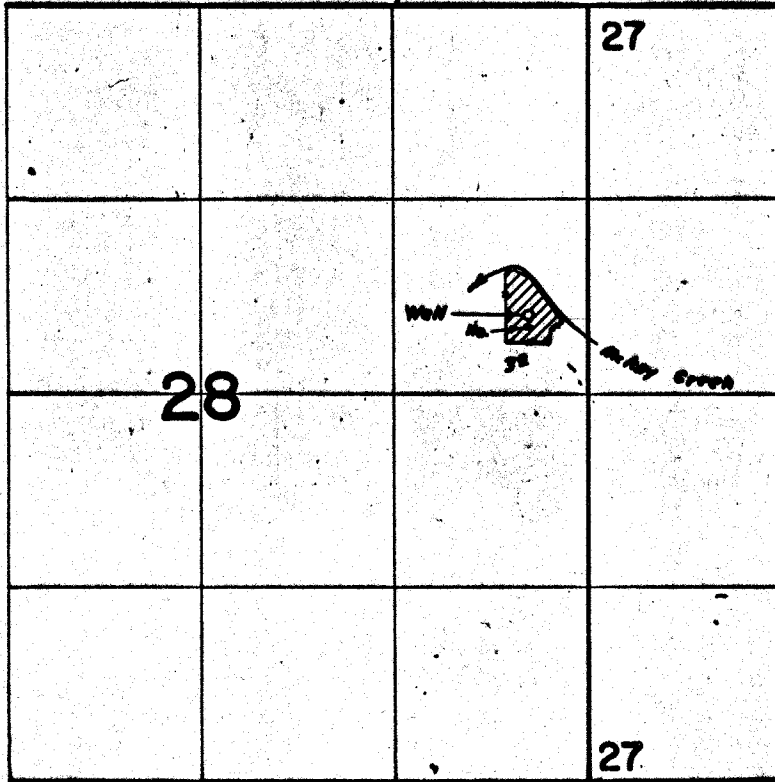

WELL LOC. 840' N & 410' W FROM E 1/4 COR. SEC. 28

FINAL PROOF SURVEY UNDER

Application No. G-2244. Permit No. G-2066.
IN NAME OF

NELS NELSON

Surveyed JUNE 26, 1971., by G. Baca